


T.16S. R.2E.W.M.

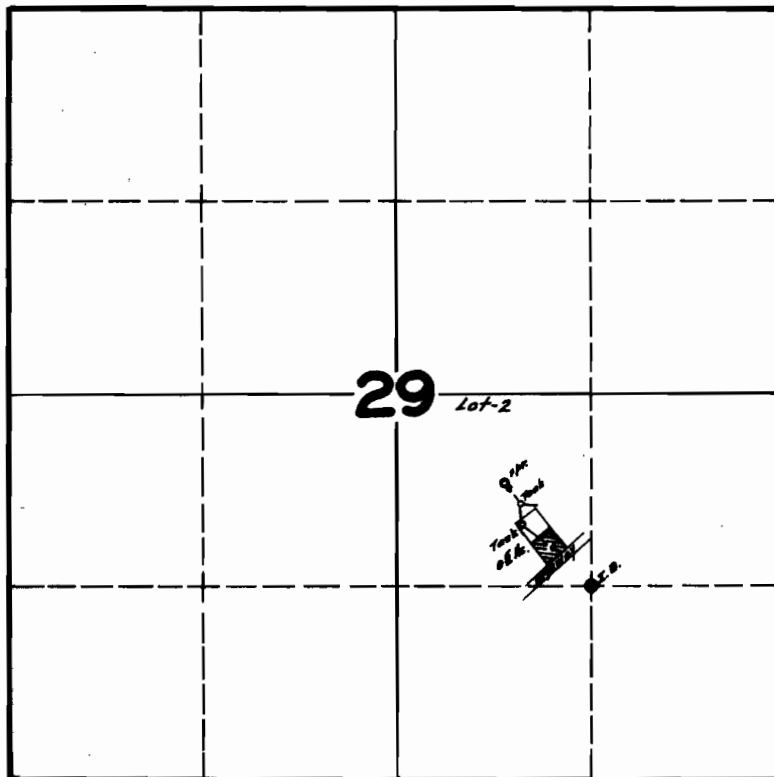

**FINAL PROOF SURVEY
UNDER**

Application No. 20083 Permit No. 15649

IN NAME OF

LLOYD M. & NANCY E. TUCKER

Surveyed AUG. 1, 1945, by [Signature]