


T.16S.R.2E.W.M.

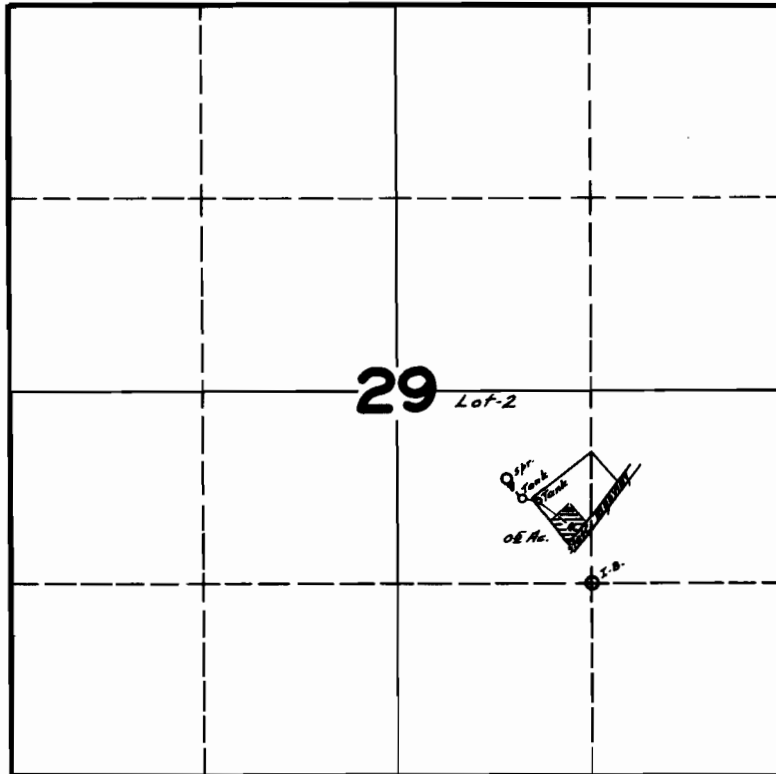

**FINAL PROOF SURVEY
UNDER**

Application No. 20084 Permit No. 15650

IN NAME OF

HARRY STANTON

Surveyed AUG. 1 1945 by [Signature]