


T.27S. R.6W.W.M.

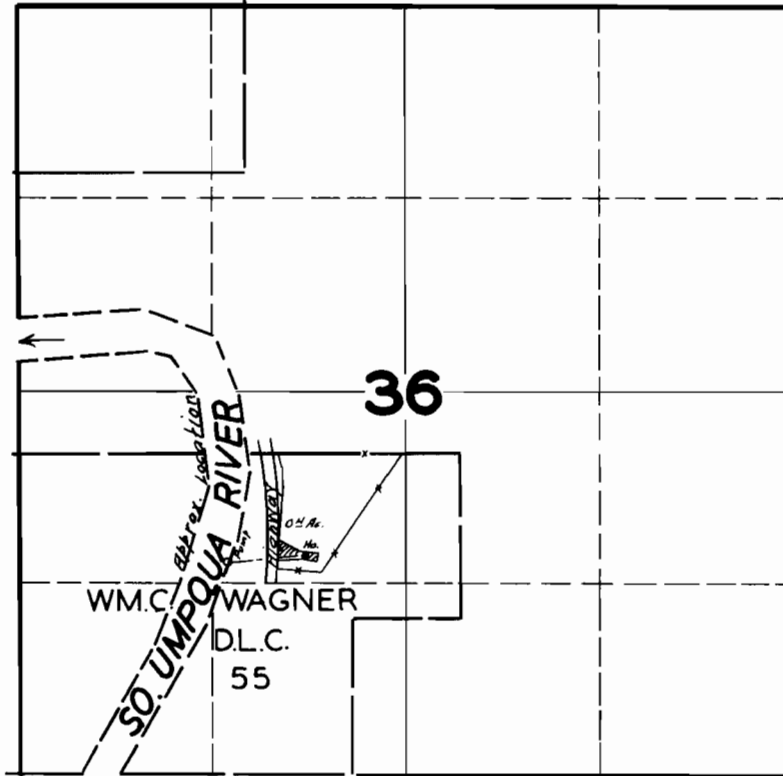

FINAL PROOF SURVEY
UNDER

Application No. 20070 Permit No. 15674

IN NAME OF

CLIFF THORNTON

Surveyed JULY 13, 1945, by