


T.27S. R.5W.W.M.

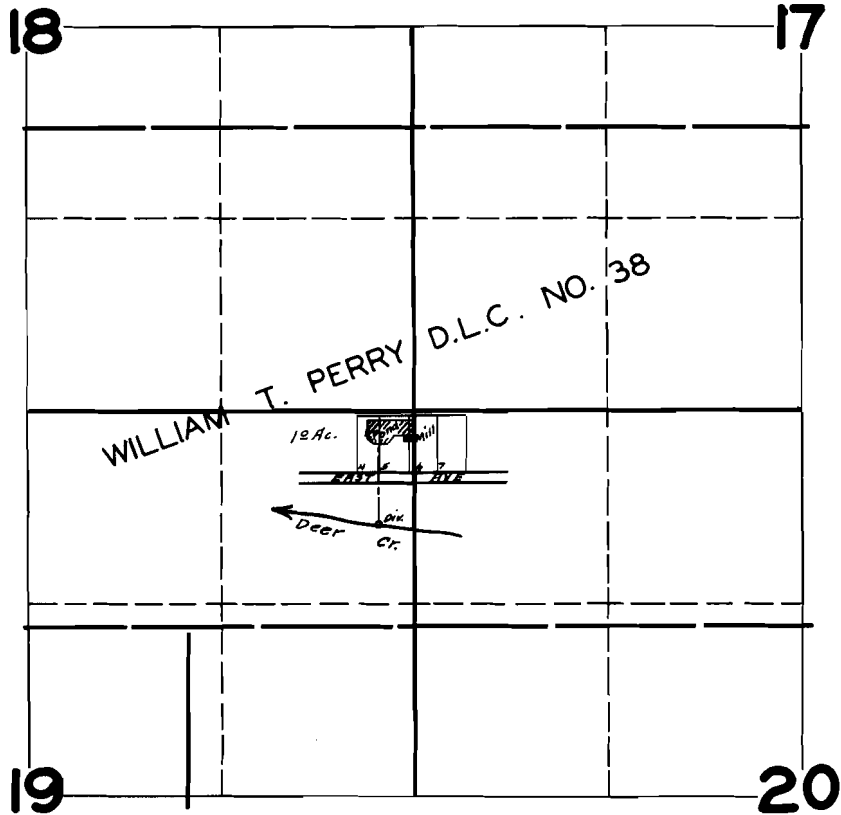

FINAL PROOF SURVEY UNDER

Application No. 20077. Permit No. 15681

IN NAME OF

JOELSON LUMBER COMPANY

Surveyed JULY 11, 1945, by