


# T.7S.R.IW.W.M.

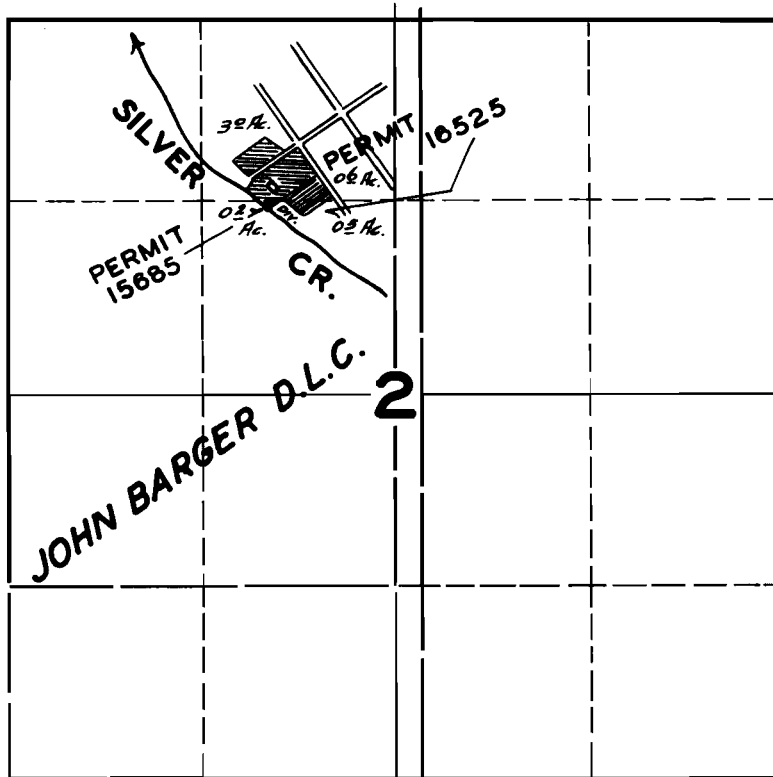

## FINAL PROOF SURVEY

UNDER

Application No. 20115 15685  
21087 Permit No. 16525

IN NAME OF

WALTER LEISY

Surveyed SEP. 29 1945, by JAS. E. BUNNELL