


T.9S. R.3W.W.M.

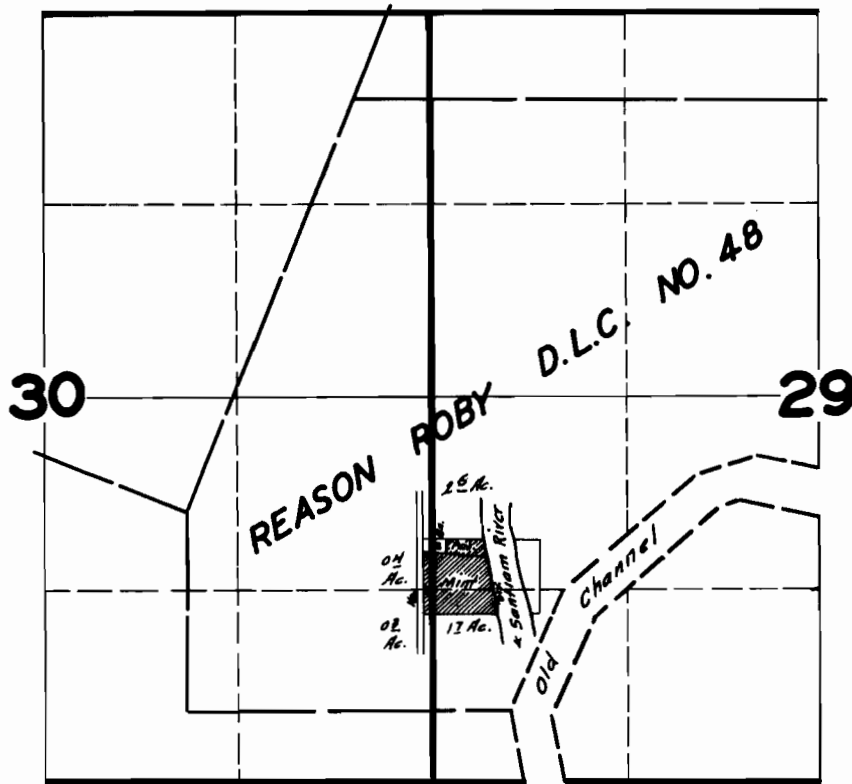

**FINAL PROOF SURVEY
UNDER**

Application No. 20128 Permit No. 15691

IN NAME OF

RAY W. GARKICK

Surveyed MAY 17, 1945, *Wm. H. Russell*