


T.10S. R. 7W.W.M.

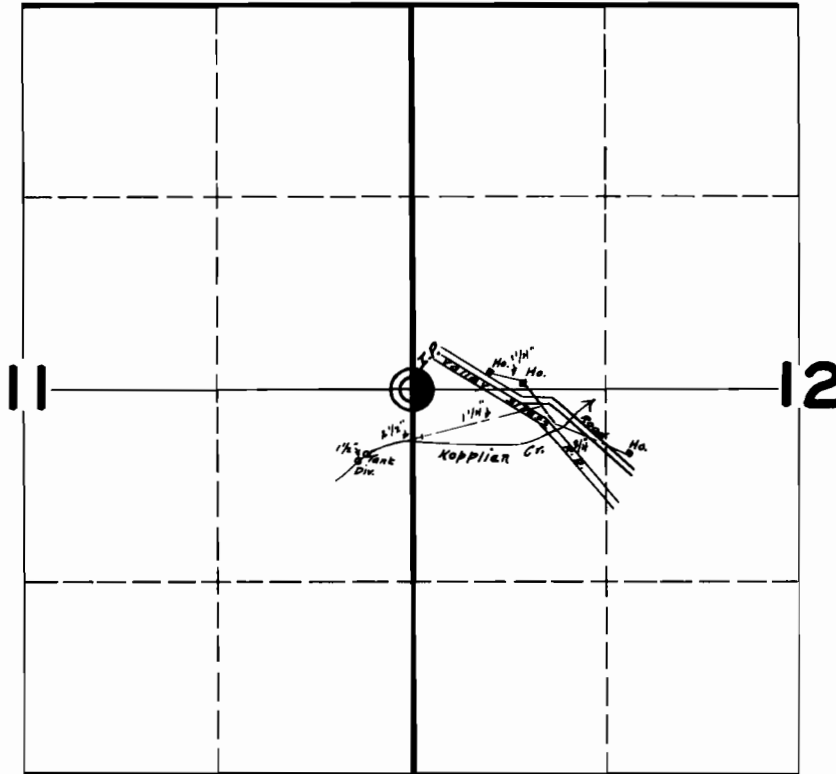

FINAL PROOF SURVEY UNDER

Application No. 20136 Permit No. 15697

IN NAME OF

ARTHUR KOPPLIEN & ROBT. KOPPLIEN

Surveyed JULY 24 1945, by *James R. [Signature]*