


T.4S. R.10W.W.M.

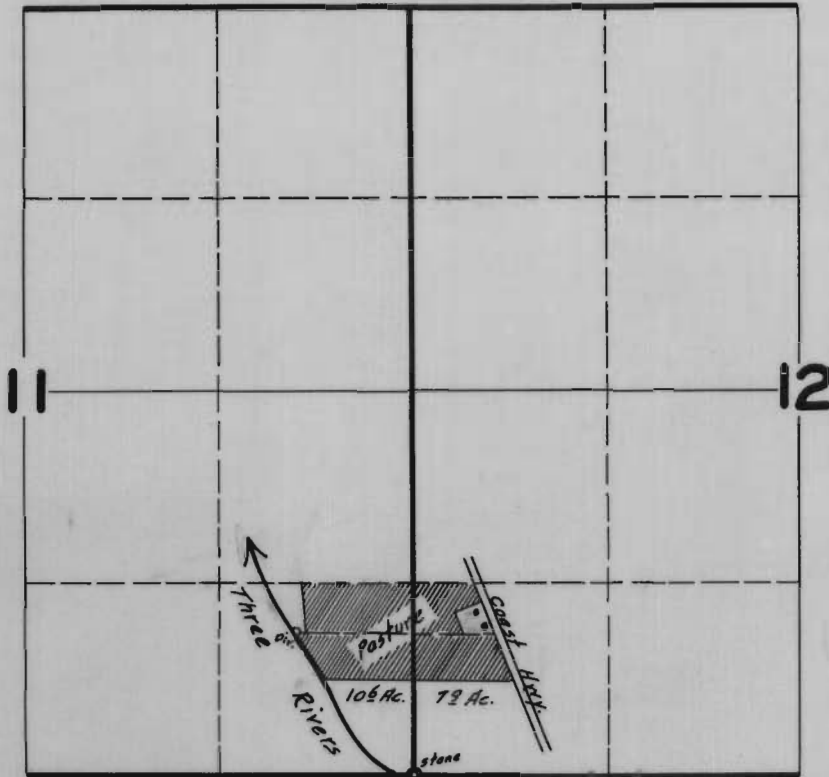

**FINAL PROOF SURVEY**  
UNDER

Application No. 20154 Permit No. 15707

IN NAME OF

HARRY RENZELMAN

Surveyed JUNE 18 1945 by [Signature]