


T.29S. R.12W.W.M.

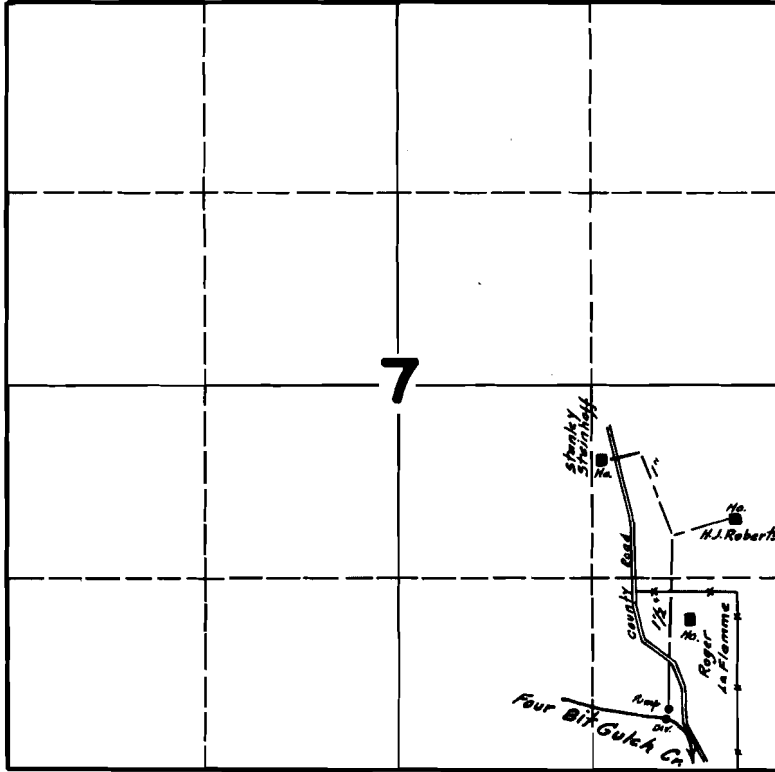

FINAL PROOF SURVEY

UNDER

Application No. 20192 Permit No. 15744

IN NAME OF

H. J. ROBERTS

Surveyed JULY 19, 1945, by James E. Samuel