


T. IN. R. IOW. W. M.

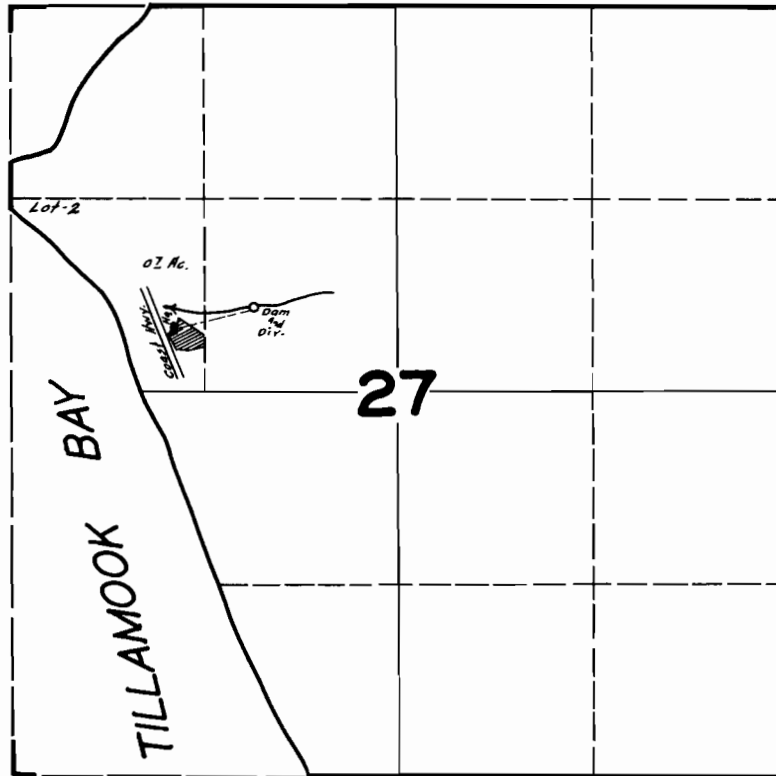

**FINAL PROOF SURVEY
UNDER**

Application No. 20216 Permit No. 15765

IN NAME OF

MARGARET LICHENTHALER

Surveyed JUNE 19 1945, by

[Handwritten signature]