


# T.3S. R. IW.W.M.

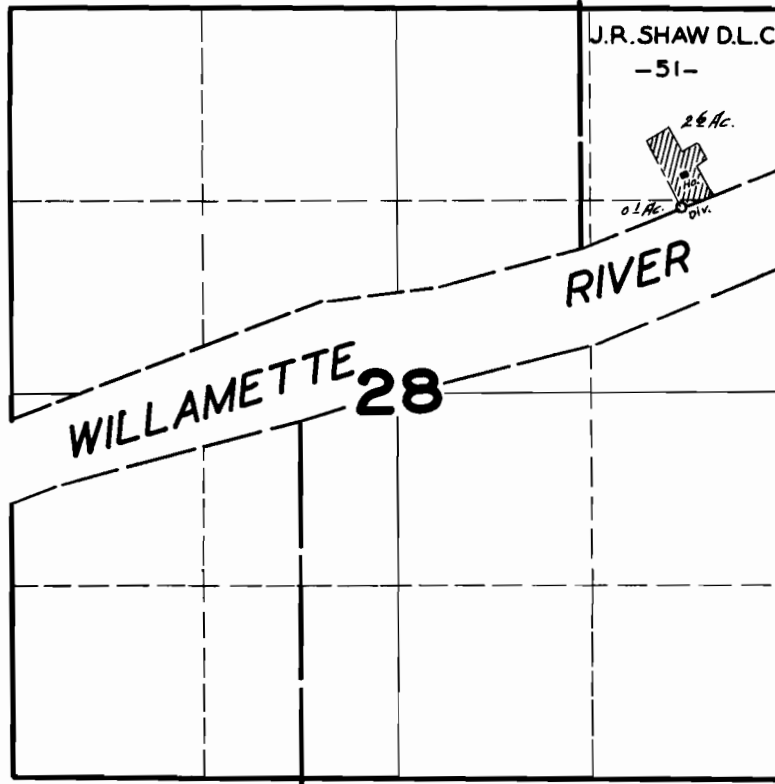

## FINAL PROOF SURVEY UNDER

Application No. 20225 Permit No. 15769

IN NAME OF

U.S. HARKSON

Surveyed MAY 5, 1945, by

*James P. Sumrell*