


T.2S. R.2E. W.M.

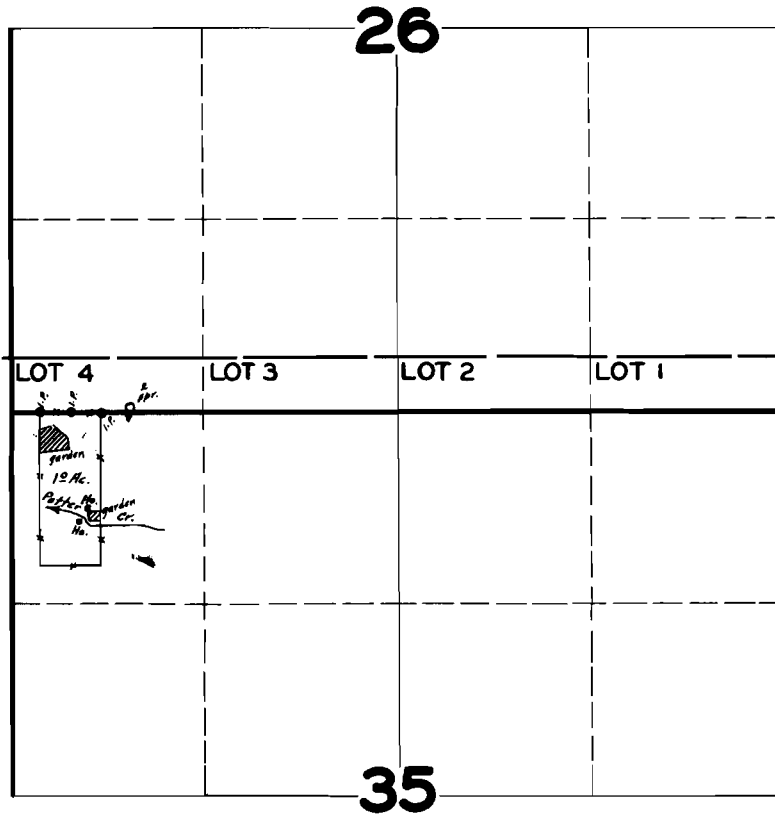

FINAL PROOF SURVEY
UNDER

Application No. 20235 Permit No. 15776

IN NAME OF

ALFRED P. WAER & LUCY F. WAER

Surveyed SEPT. 5 1945 by [Signature]