


T.6S. R.1W.W.M.

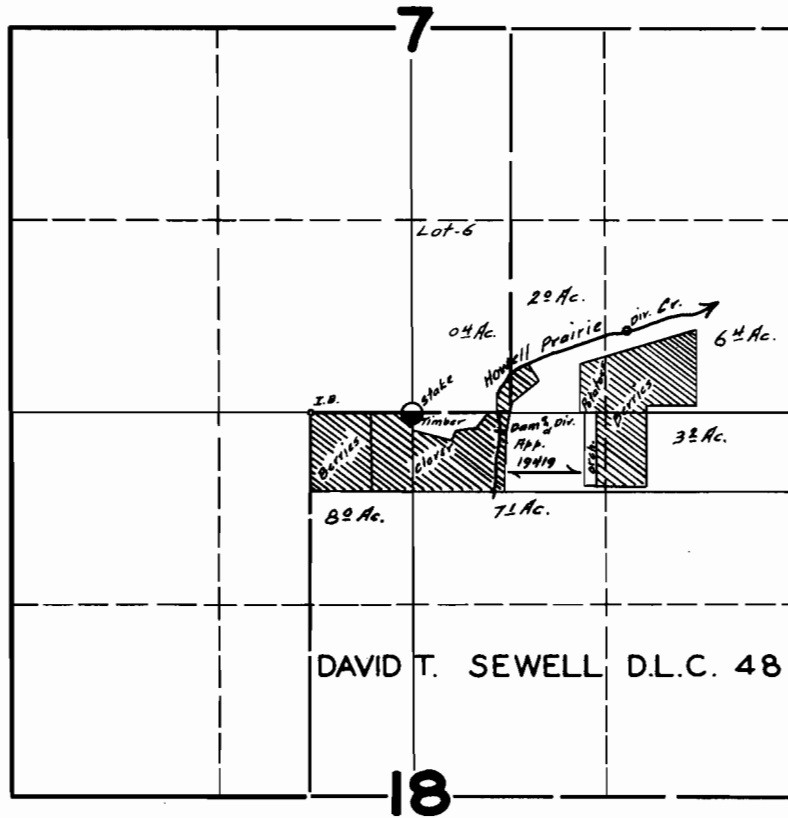

FINAL PROOF SURVEY UNDER

Application No. 20291 Permit No. 15829

IN NAME OF

FRANK PICKENS

Surveyed SEPT. 29 1945, by David T. Sewell