


T.3S. R.2E.W.M.

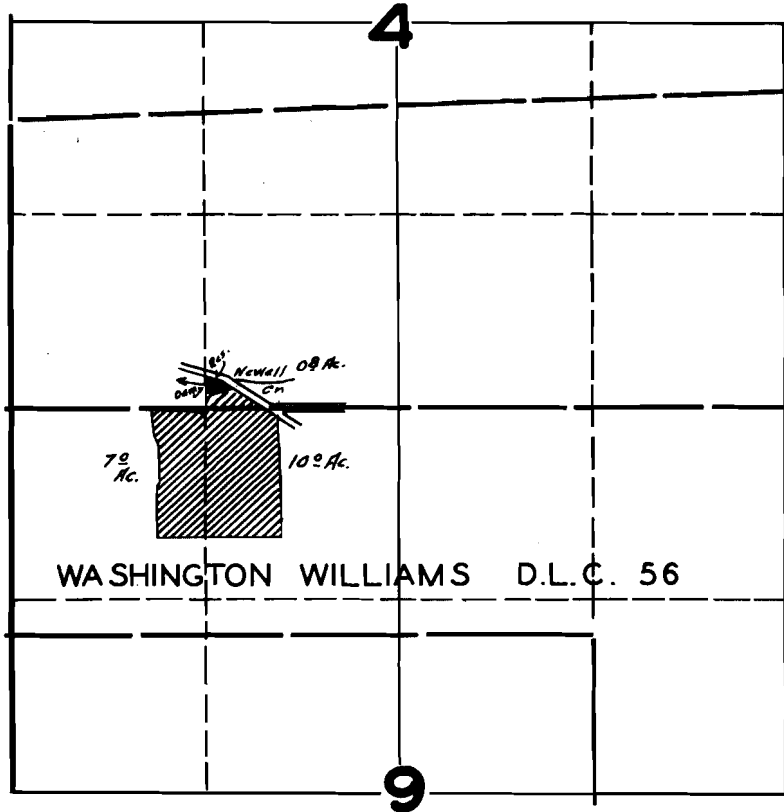

FINAL PROOF SURVEY
UNDER

Application No. 20371 Permit No. 15888

IN NAME OF

JOE PAVLINAC

Surveyed SEPT. 6 1945, by James C. Russell