


# T.9&10S.R.3W.W.M.

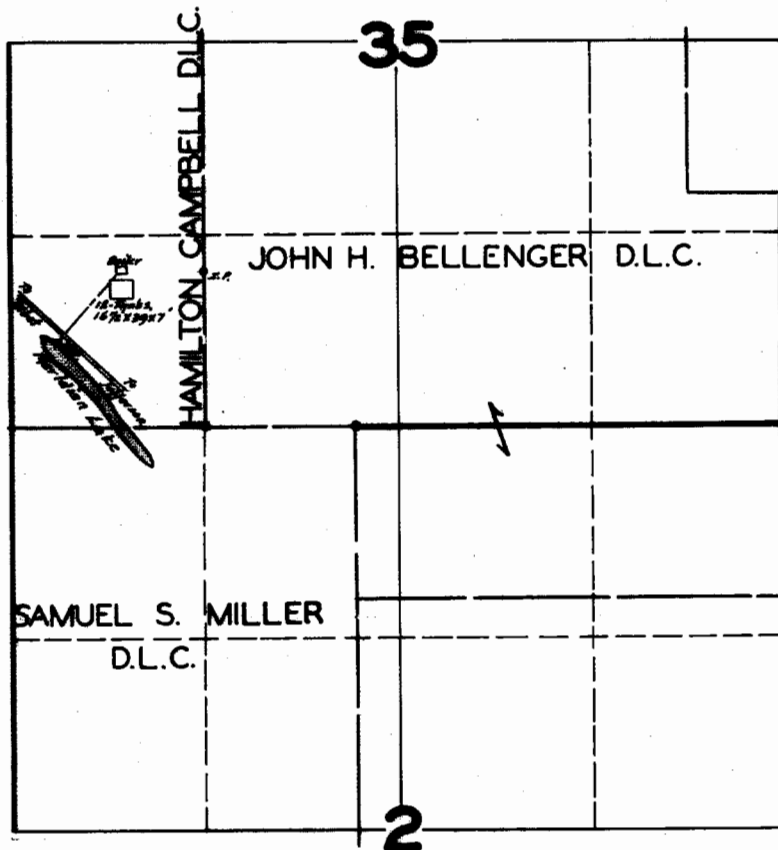

## FINAL PROOF SURVEY UNDER


Application No. 20385 Permit No. 15898

IN NAME OF

SANTIAM FLAX GROWERS

Surveyed MAY 21, 1945, by *[Signature]*

T.9S. R.2W.W.M.

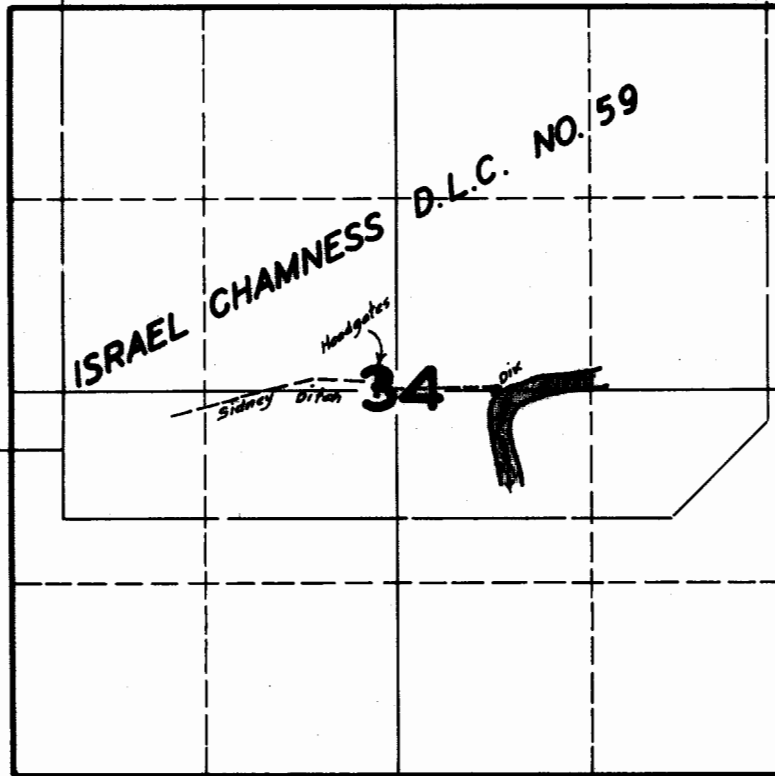

**FINAL PROOF SURVEY**

UNDER

Application No. 20385 Permit No. 15898

IN NAME OF

SANTIAM FLAX GROWERS

Surveyed MAY 21, 1945 by [Signature]