


# T.4S. R.1E.W.M.

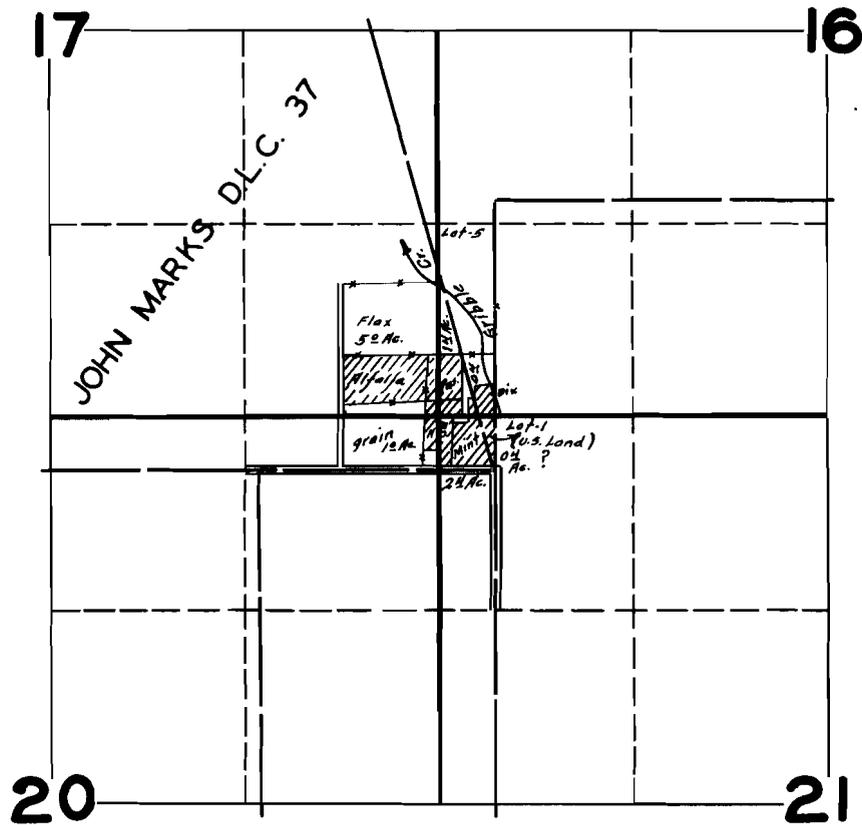

## FINAL PROOF SURVEY UNDER

Application No. 20392 Permit No. 15902

IN NAME OF

E. L. MC CAULEY

Surveyed AUG. 17 1945, by

*James E. Sumner*