


T. 7S. R. 3W.W.M.

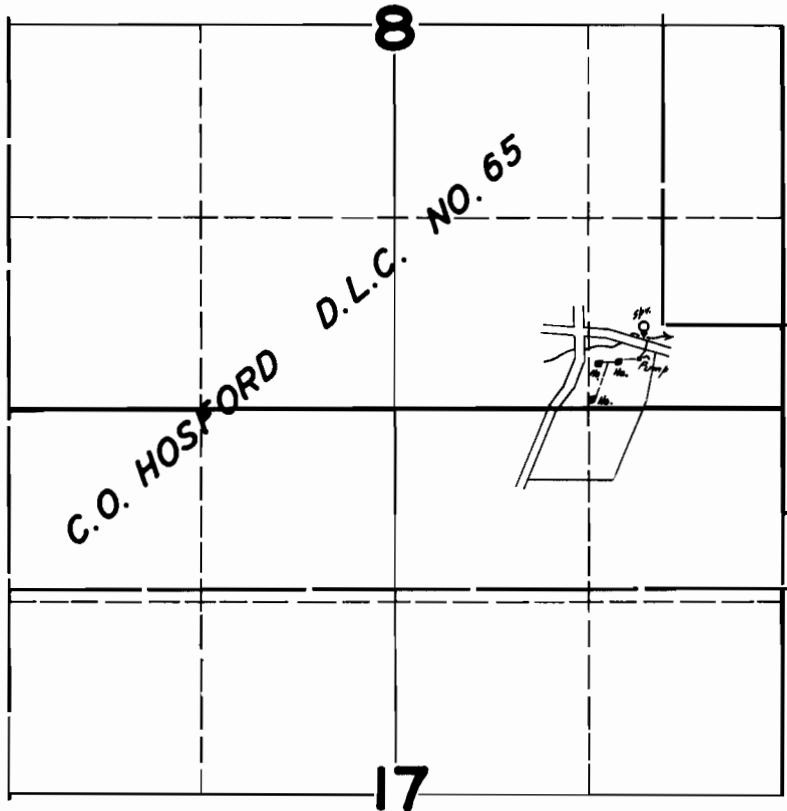

**FINAL PROOF SURVEY**  
UNDER

Application No. 20405 Permit No. 15936

IN NAME OF

FRED S. BYNON - GEO. E. BYNON - JESSIE HARRITT

Surveyed JUNE 2 1945, by *J. E. Russell*