


T.26S. R.4W.W.M.

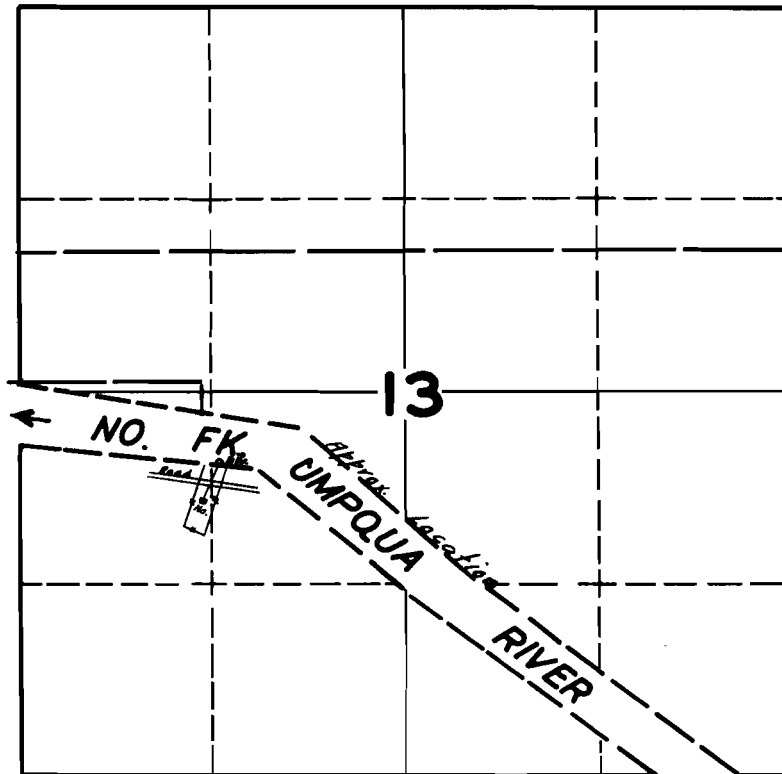

**FINAL PROOF SURVEY**  
**UNDER**

Application No. 20413 Permit No. 15941

IN NAME OF

MRS. R.C. NOLAND

Surveyed JULY 11 1945, by James C. Sumrell