


T.15S. R.12W.W.M.

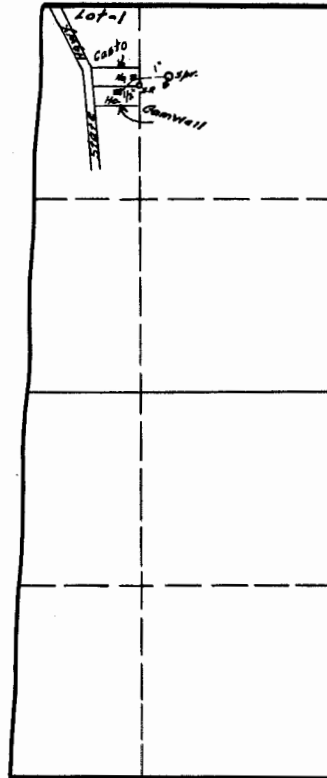

PACIFIC OCEAN
27



FINAL PROOF SURVEY
UNDER

Application No. 20426 Permit No. 15950

IN NAME OF

CHARLES W. CASTO & E. S. GAMWELL

Surveyed AUG. 8, 1945, by J. B. Russell