


T.4S. R.7W.W.M.

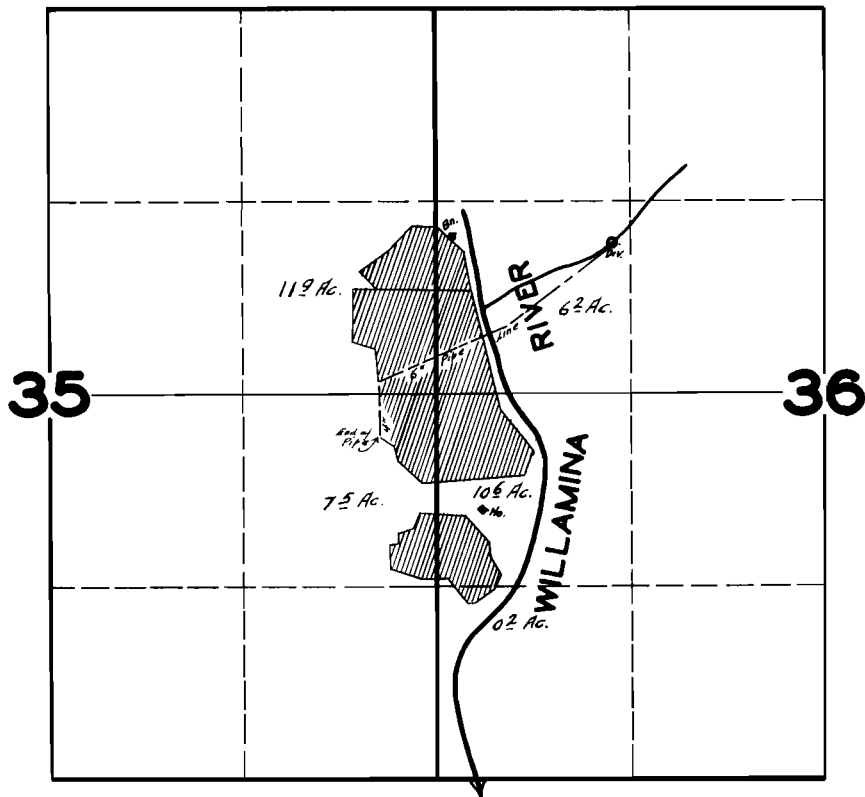

FINAL PROOF SURVEY UNDER

Application No. 20460 Permit No. 15974

IN NAME OF

ALEX CRUICKSHANK

Surveyed JULY 5, 1945, by