


T. 17S. R. 9W. W.M.

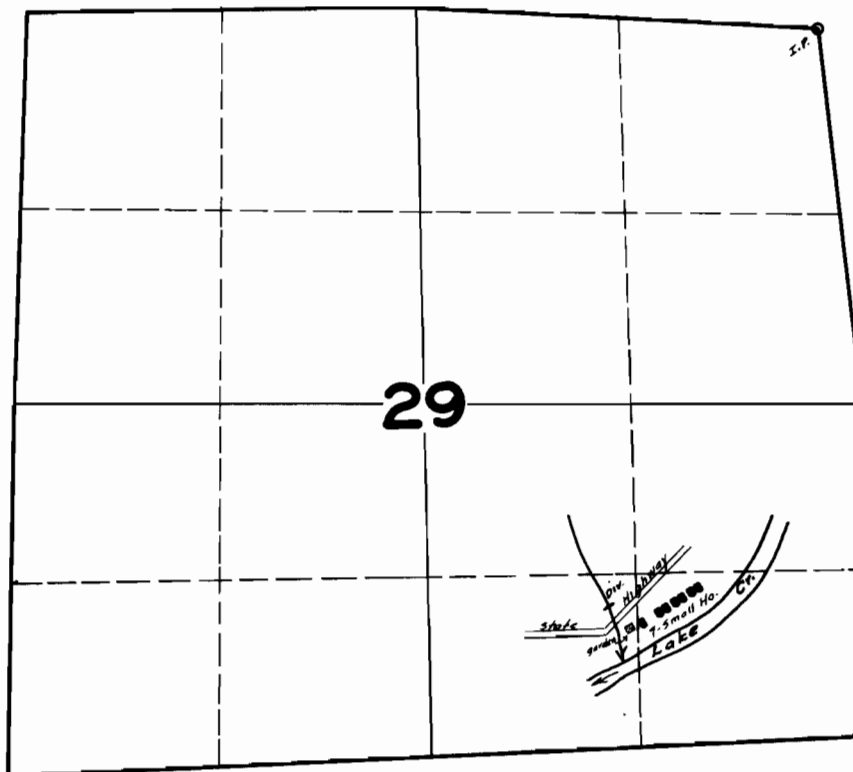

FINAL PROOF SURVEY

UNDER

Application No. 20484 Permit No. 15991

IN NAME OF

DONALD S. THOMASON

Surveyed AUG. 6, 1945, by [Signature]