


T.17S. R.1W.W.M.

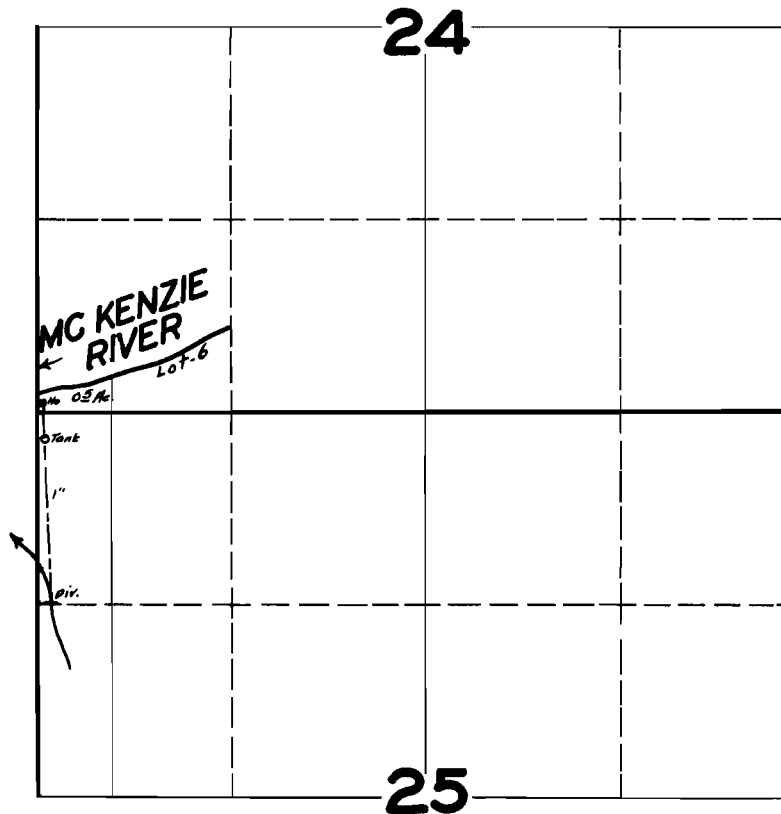

FINAL PROOF SURVEY
UNDER

Application No. 20507 Permit No. 16009

IN NAME OF

ARTHUR D. MINIMUM

Surveyed AUG. 1, 1945 by [Signature]