


T.18S.R.6W.W.M.

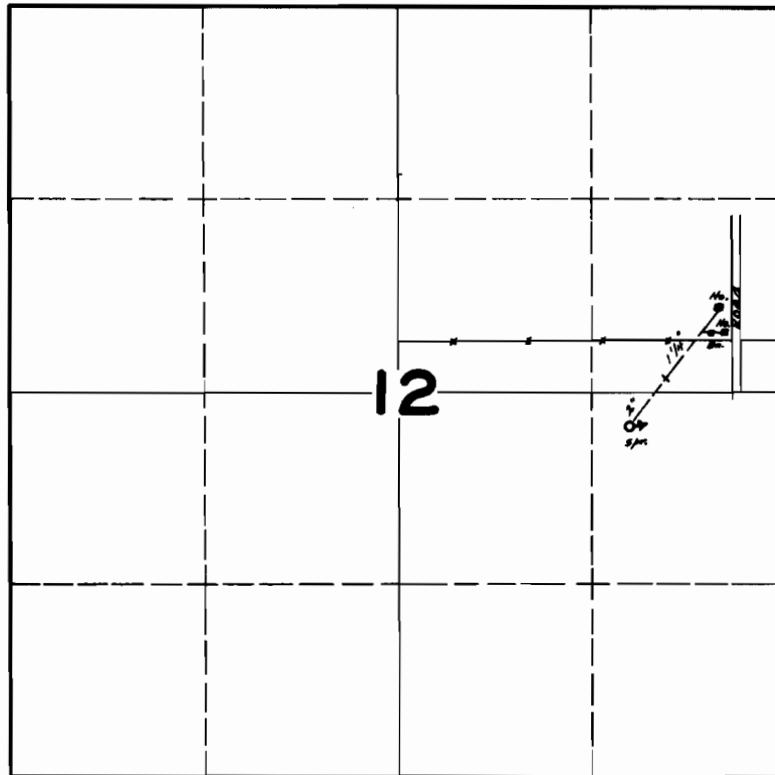

**FINAL PROOF SURVEY
UNDER**

Application No. 20517 Permit No. 16019

IN NAME OF

MORITZ W. KOCK

Surveyed AUG. 3, 1945 by [Signature]