


# T. IN. R. 4 W. W. M.

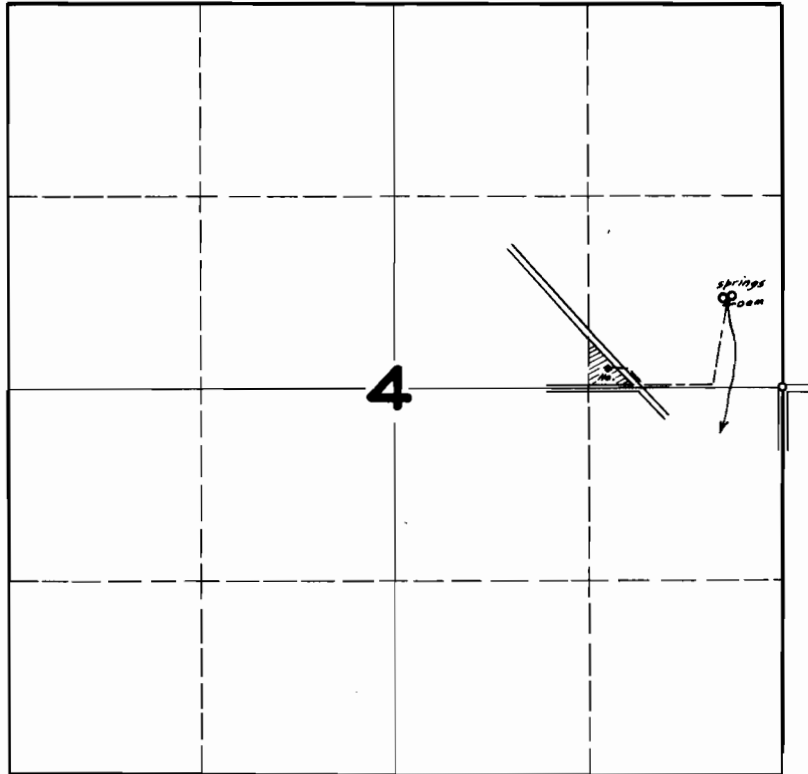

## FINAL PROOF SURVEY UNDER

Application No. 20590 Permit No. 16090

IN NAME OF

E. F. CONNELLY & MILDRED CONNELLY

Surveyed AUG. 31, 1945, by *James D. Sumrell*