


T.5S. R.5W.W.M.

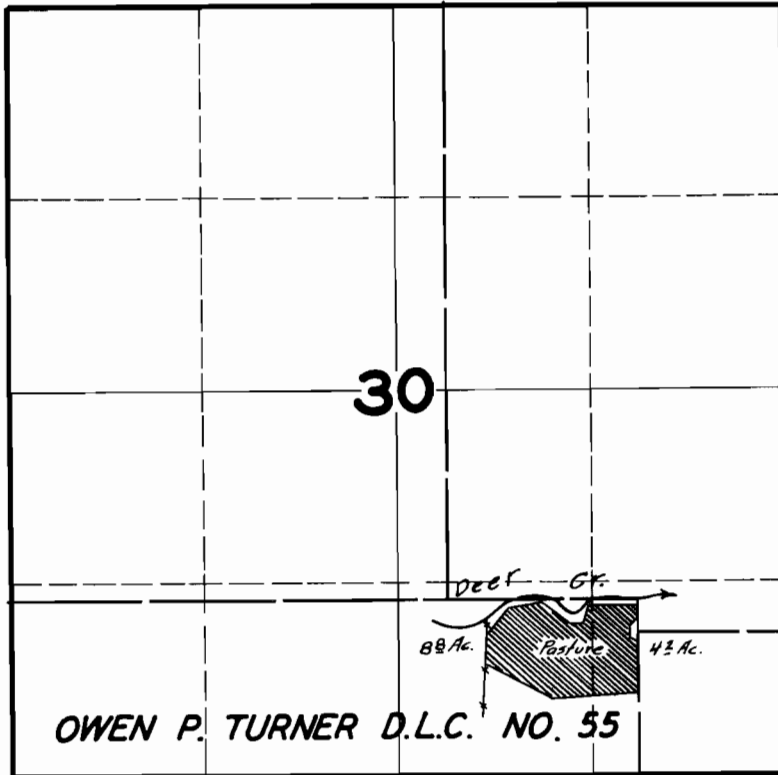

FINAL PROOF SURVEY UNDER

Application No. 20661 Permit No. 16162

IN NAME OF

B. M. WEBSTER

Surveyed JUNE 7, 1945, by

[Handwritten Signature]