


T.8S.R.4W.W.M.

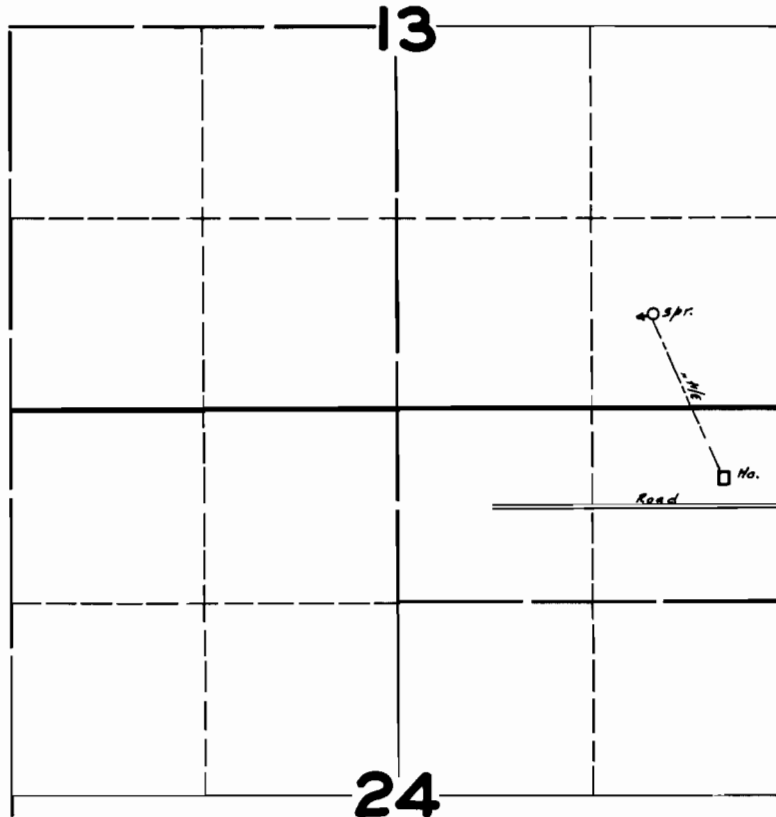

**FINAL PROOF SURVEY
UNDER**

Application No. 20663 Permit No. 16164

IN NAME OF

LEE U. EYERLY

Surveyed MAY 17, 1945, by [Signature]