


T.28S. R.6W.W.M.

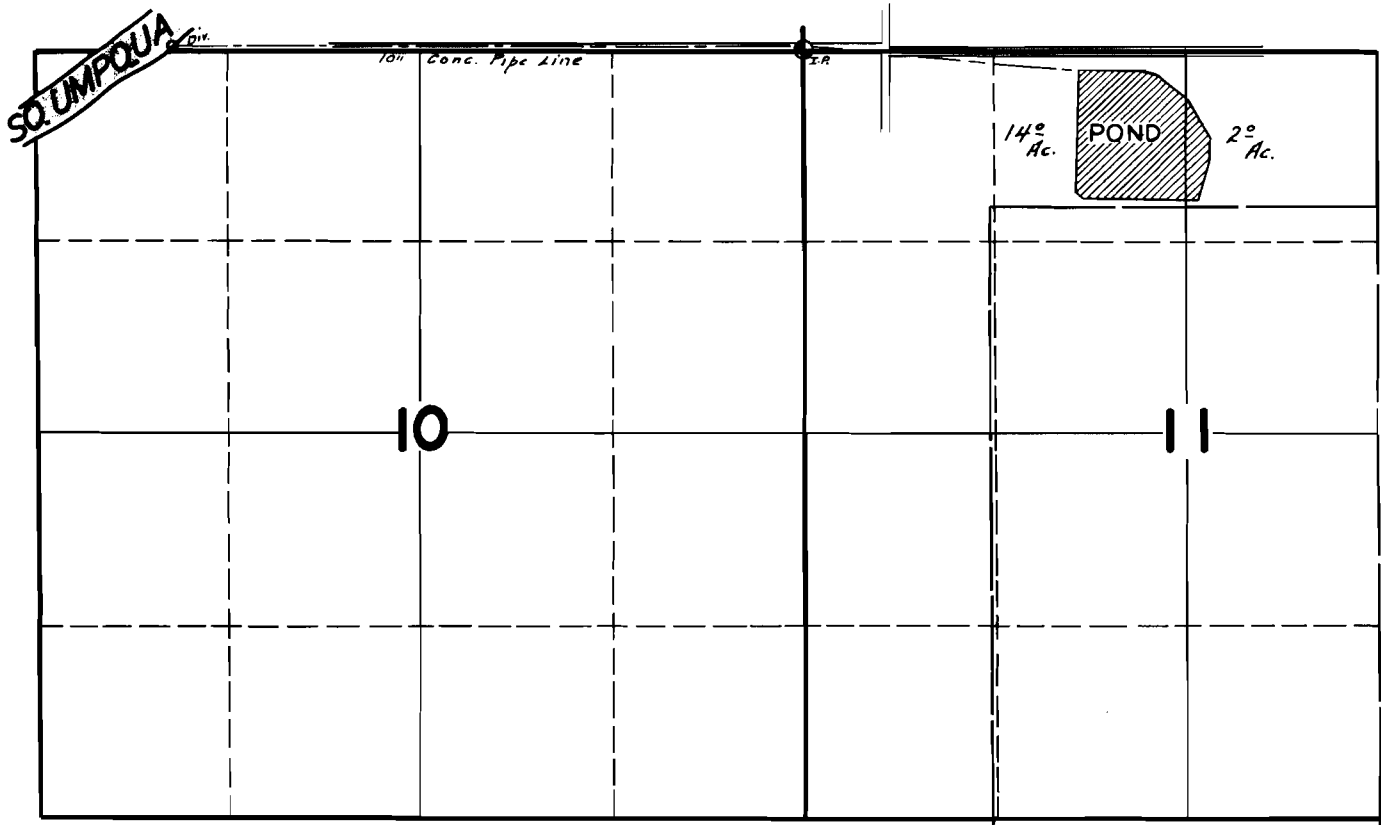

FINAL PROOF SURVEY

UNDER

R-20693

R-811

Application No. 20694 Permit No. 16187

IN NAME OF

EUGENE PLYWOOD COMPANY

Surveyed JULY 11, 1945, by *J. E. Runnel*