


T.19S.R.1W.W.M.

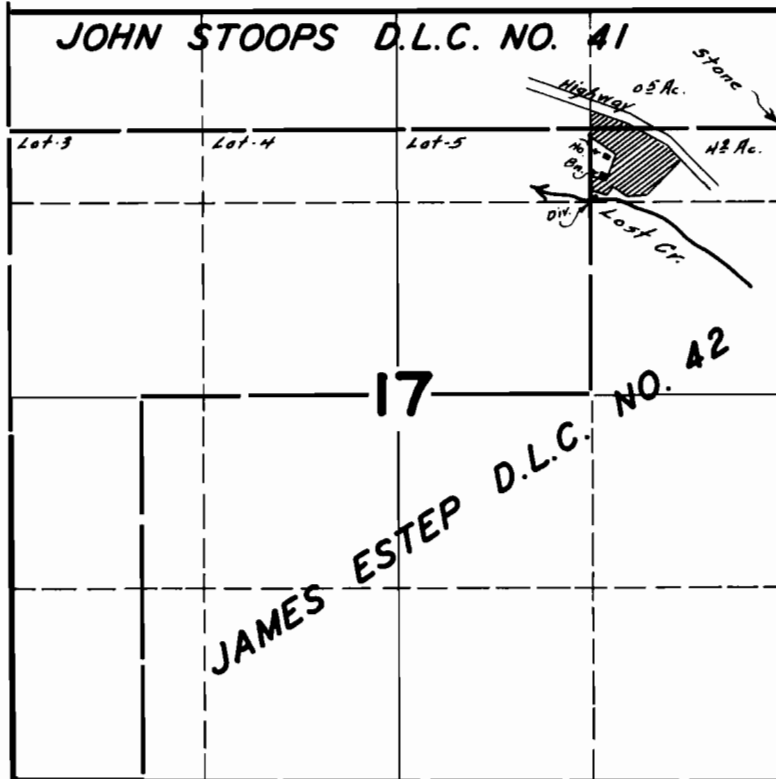

FINAL PROOF SURVEY UNDER

Application No. 20703 Permit No. 16191

IN NAME OF
TOM O. RILEY

Surveyed JULY 25 1946, by [Signature]