


T.16S. R.2E.W.M.

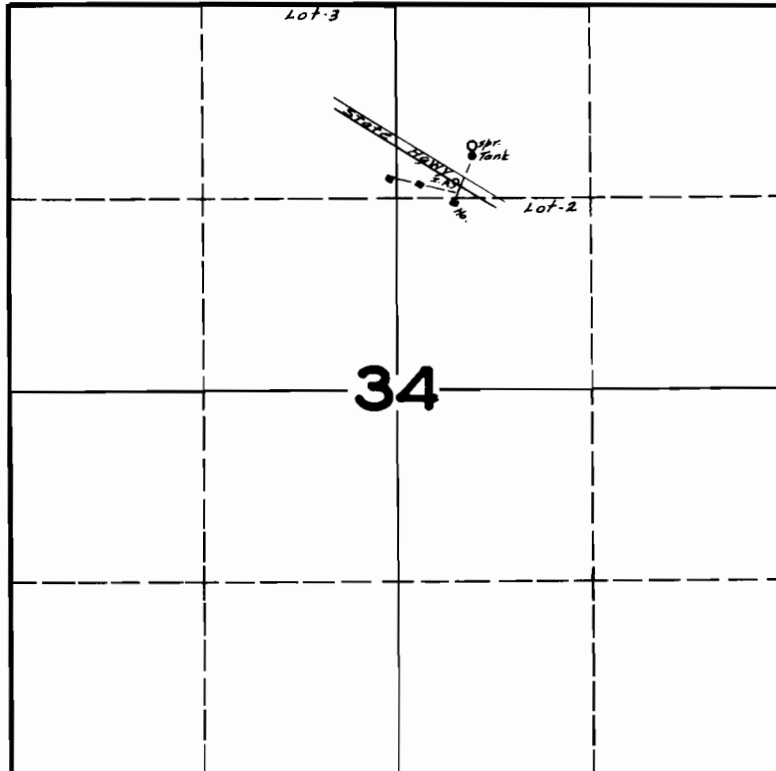

FINAL PROOF SURVEY UNDER

Application No. 20642 Permit No. 16217

IN NAME OF

H.D. & PEARL CHRISTIAN

Surveyed AUG. 1, 1945, by *J. B. Drummell*