


T.10S. R.4W.W.M.

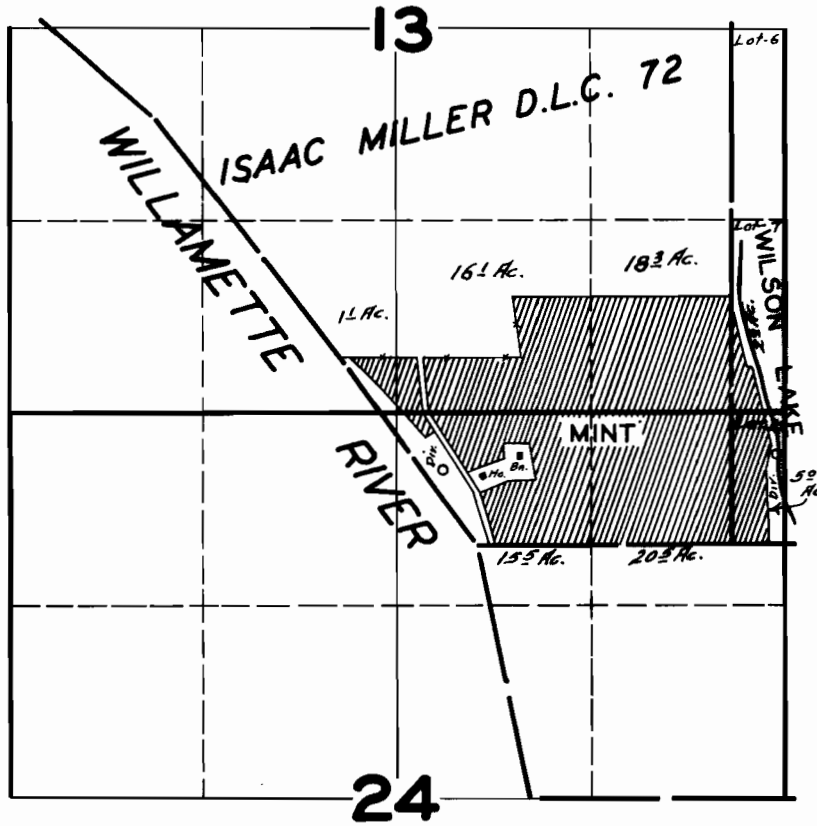

FINAL PROOF SURVEY
UNDER

Application No. 20752 Permit No. 16242

IN NAME OF

P.L. TURNIDGE

Surveyed MAR. 19 1946 by