


T.13S. R.1W.W.M.

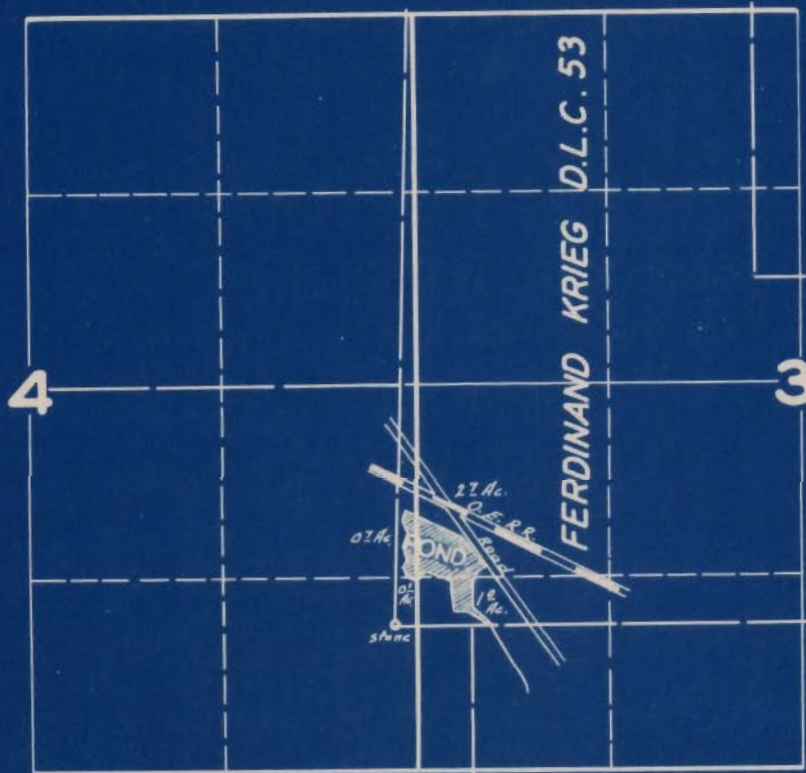

**FINAL PROOF SURVEY**  
UNDER

Application No. 20796 Permit No. 16274

IN NAME OF

JOHN NYLUND

Surveyed JULY 26 1945 by *Samuel*