


T.6S. R.3W.W.M.

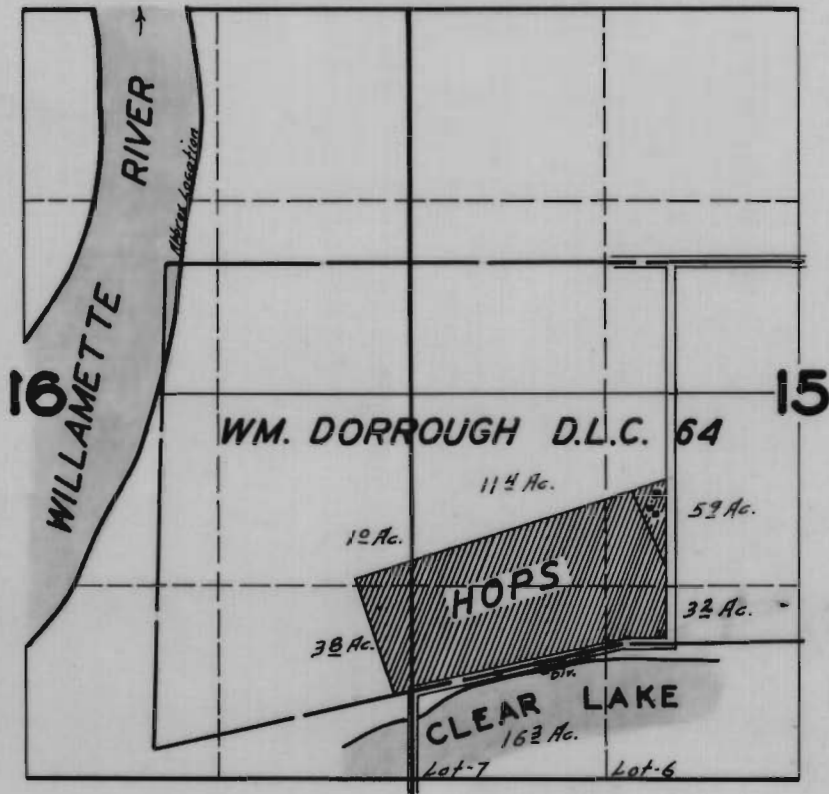

**FINAL PROOF SURVEY**  
UNDER

Application No. 20805 Permit No. 16281

IN NAME OF  
RAY KERR OF KERR HOP RANCH

Surveyed AUG. 13 1945, by *[Signature]*