


Township 35 South, Range 8 West, W. M.

Portion of Section 1.

May 1945

Scale 400' = 1"

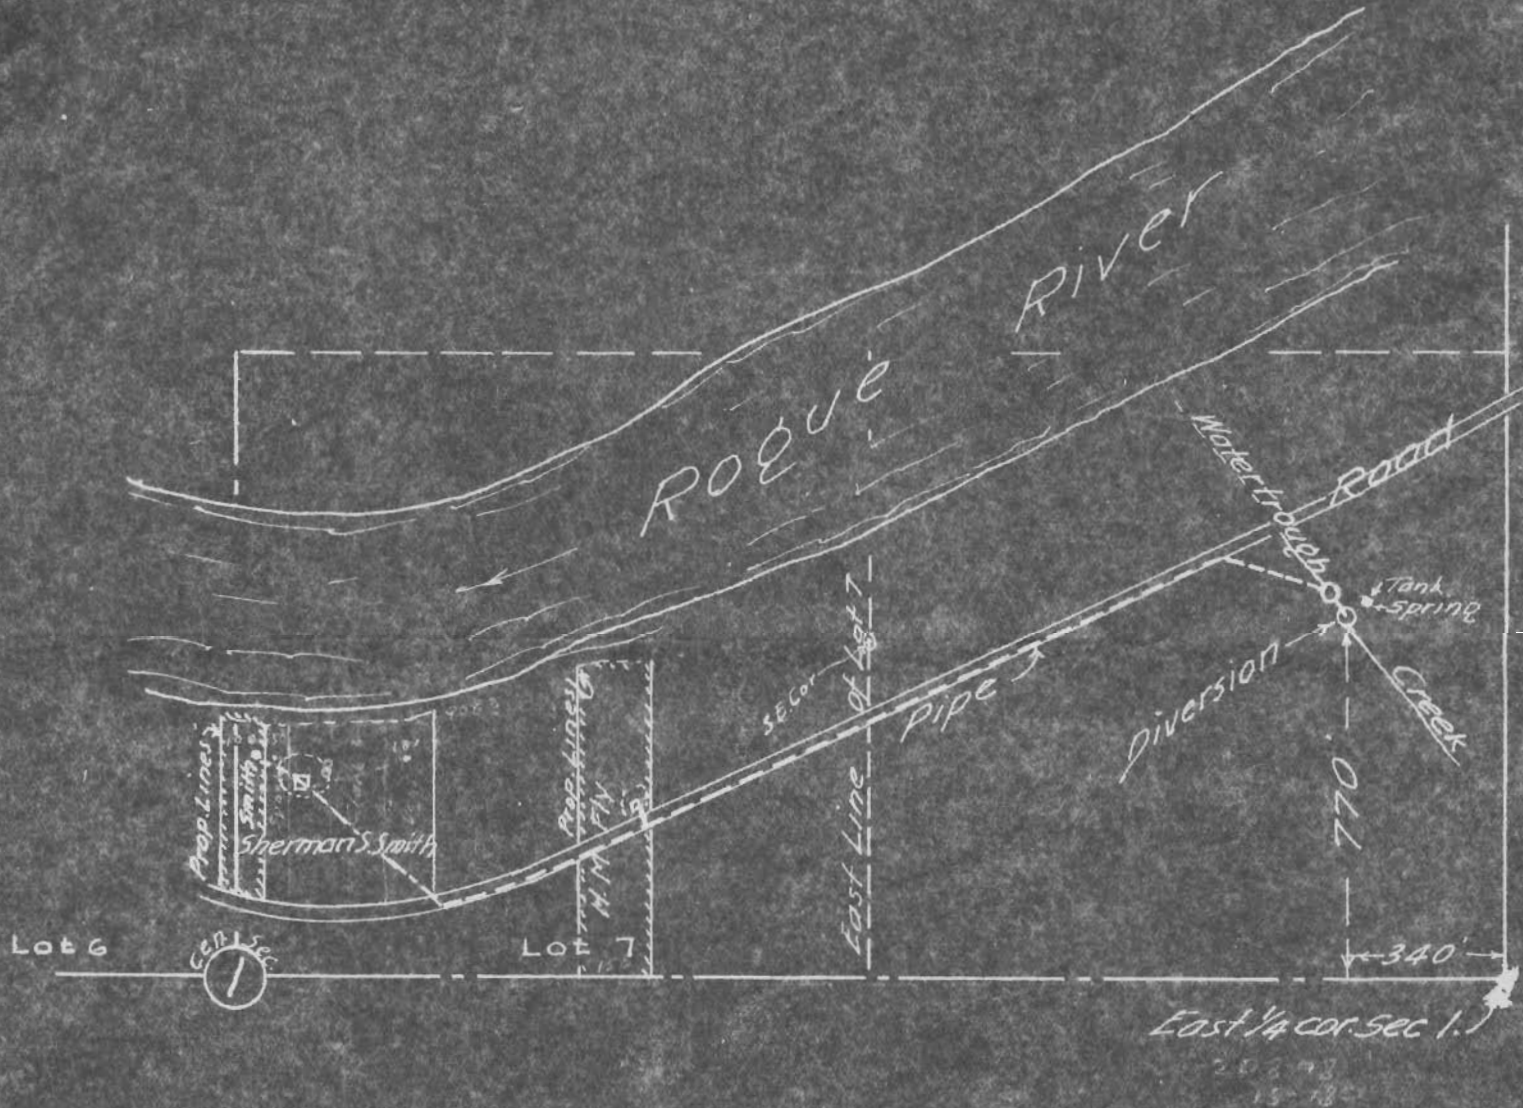

H. M. Fly
Sherman S. Smith

Application No. 20848

Permit No. 16306