


Township 35 South, Range 8 West, W. M.

Portion of Section 1

May 1945

Scale 400'=1"

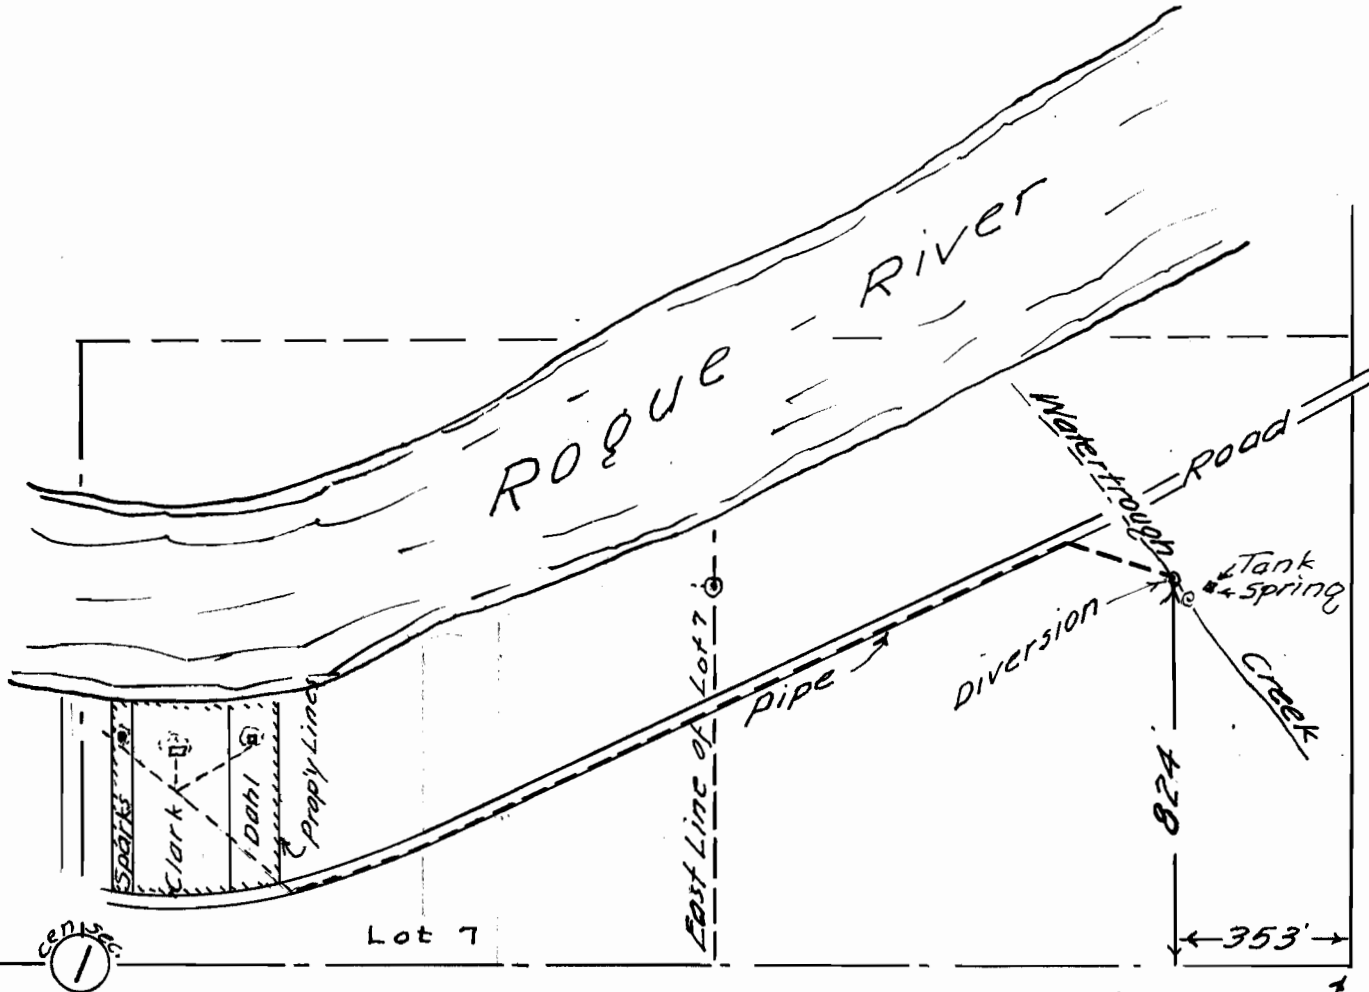

East 1/4 cor. Sec. 1
20849
15-780

Frank Sparks
Sherman Dahl
Marvin Clark

Application No... 20849
Permit No... 16307

RECEIVED
MAY 14 1945
WATER DIVISION
