


T.5S. R.3E.W.M.

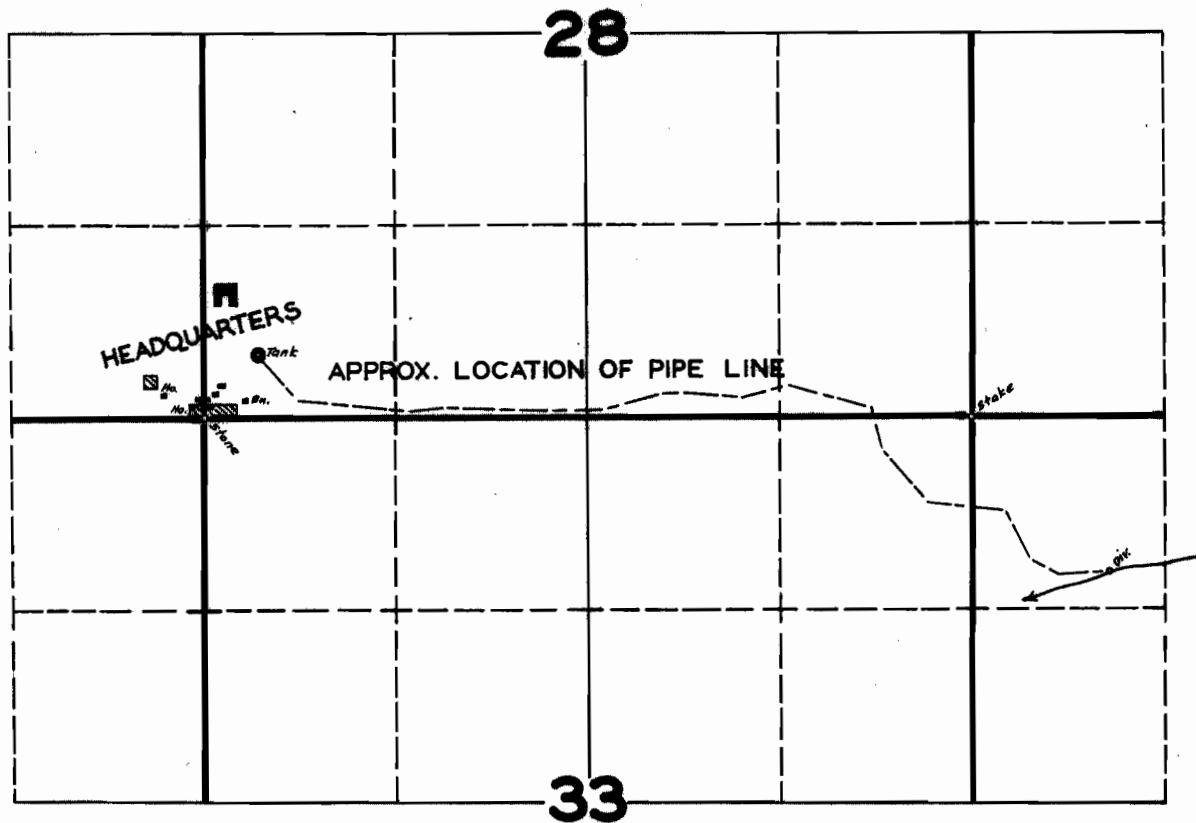

FINAL PROOF SURVEY
UNDER

Application No. 20876 Permit No. 16350

IN NAME OF

CLACKAMAS-MARION COUNTIES FIRE PATROL ASSOCIATION

Surveyed MAR. 21 1946 by [Signature]