


31

TOWNSHIP 37S, RANGE 1W, W. M.

North

Scale - 1" = 660'

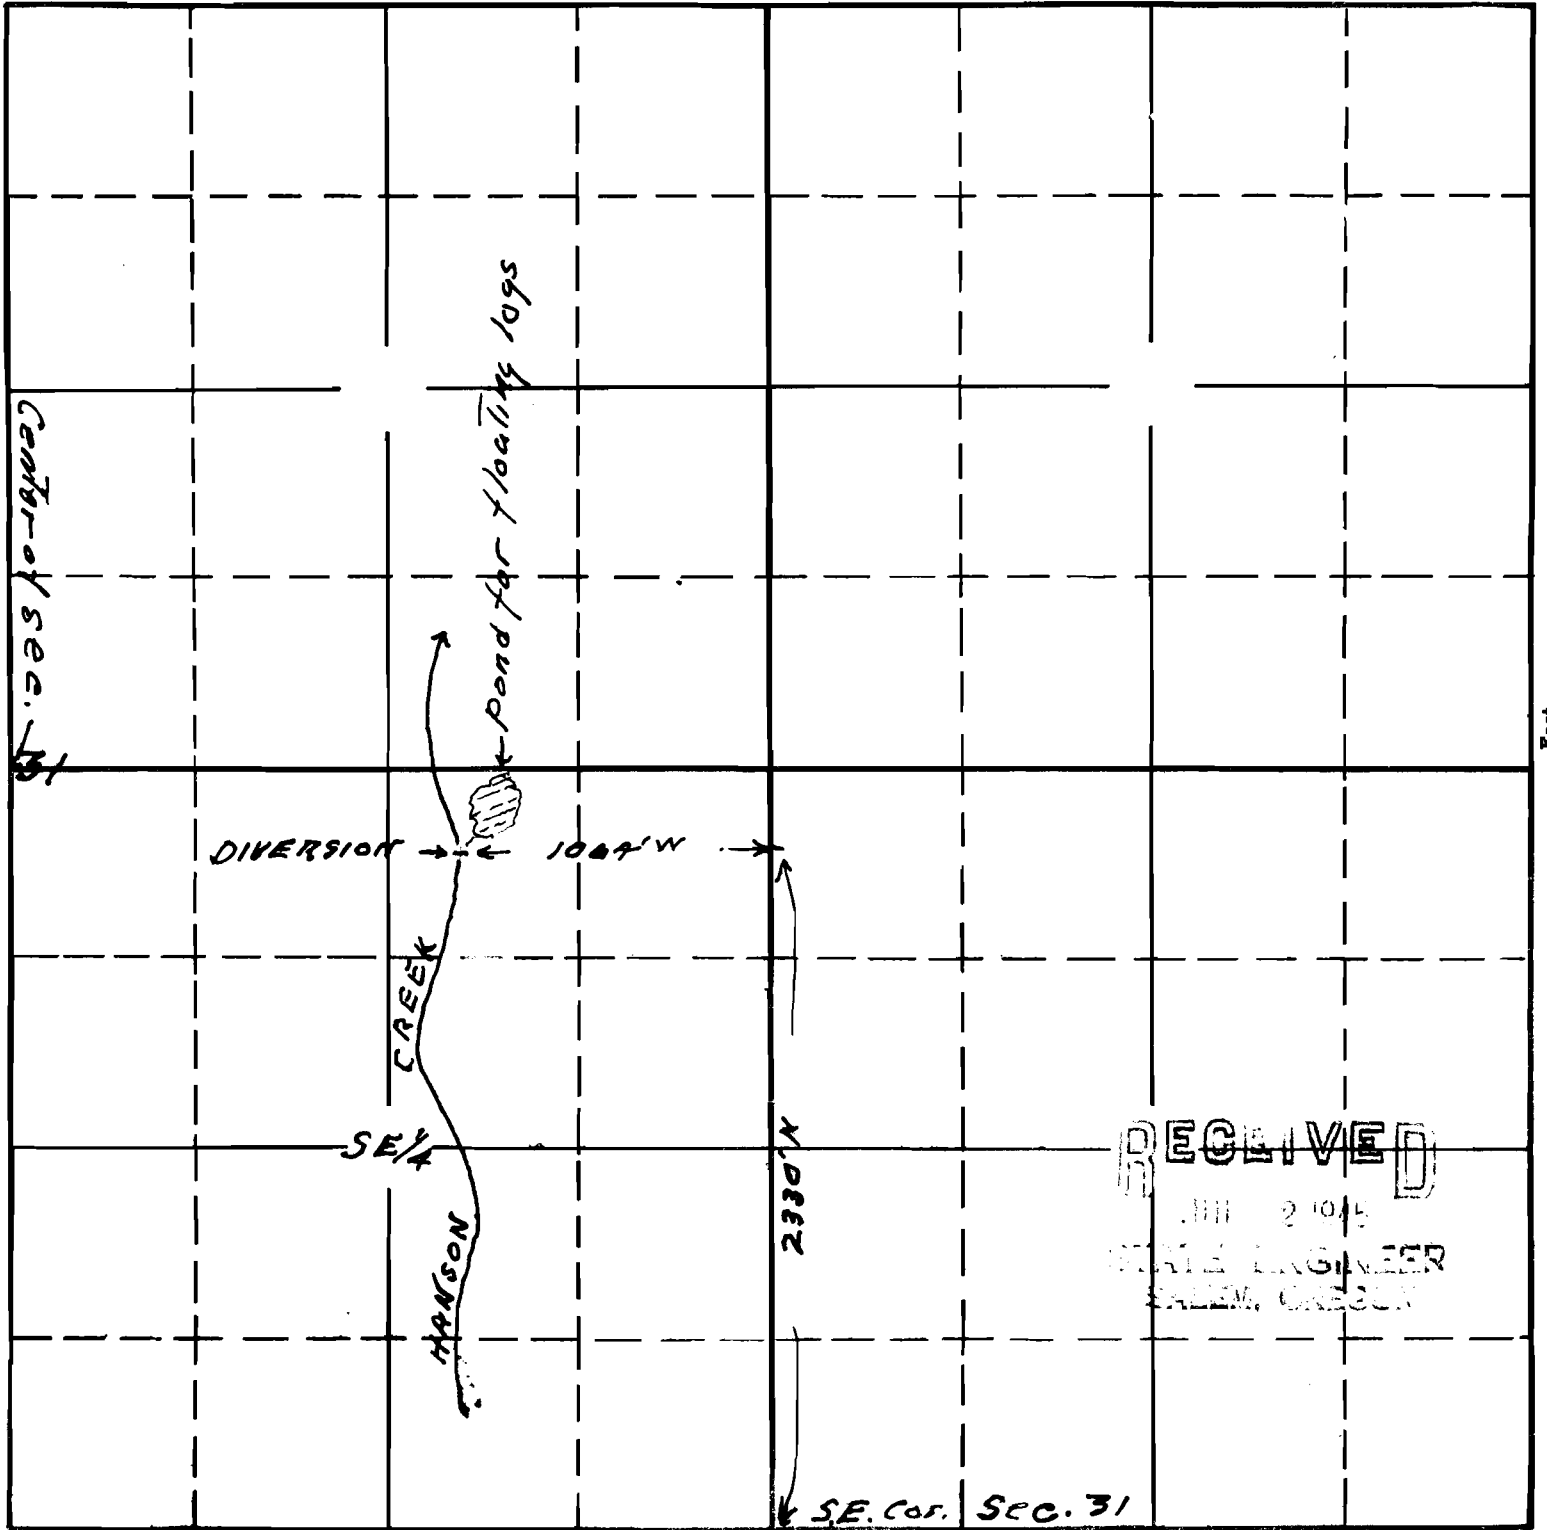

RECEIVED
 JUN 2 1915
 STATE ENGINEER
 SALEM, OREGON

South

20934
15-23

Map to accompany application of
 Squaw Mountain Timber Co. A. A. Lausmann, Sec. PERMIT No. 16392
 for use of waters of Hanson Cr. for
 manufacturing use.

This office 2/27/15