


T.3S.R.3W.W.M.

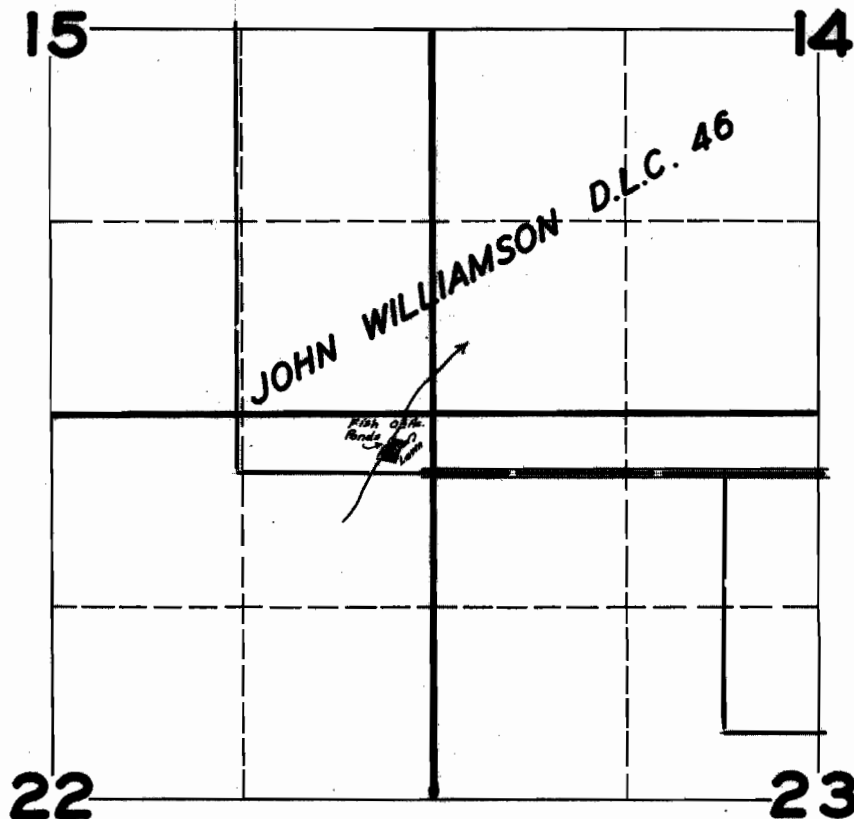

**FINAL PROOF SURVEY
UNDER**

Application No. 20958 Permit No. 16405

IN NAME OF

RALPH A. BUTT

Surveyed MAR. 8, 1946, by [Signature]