


T. 7 S. R. 1 W. W. M.

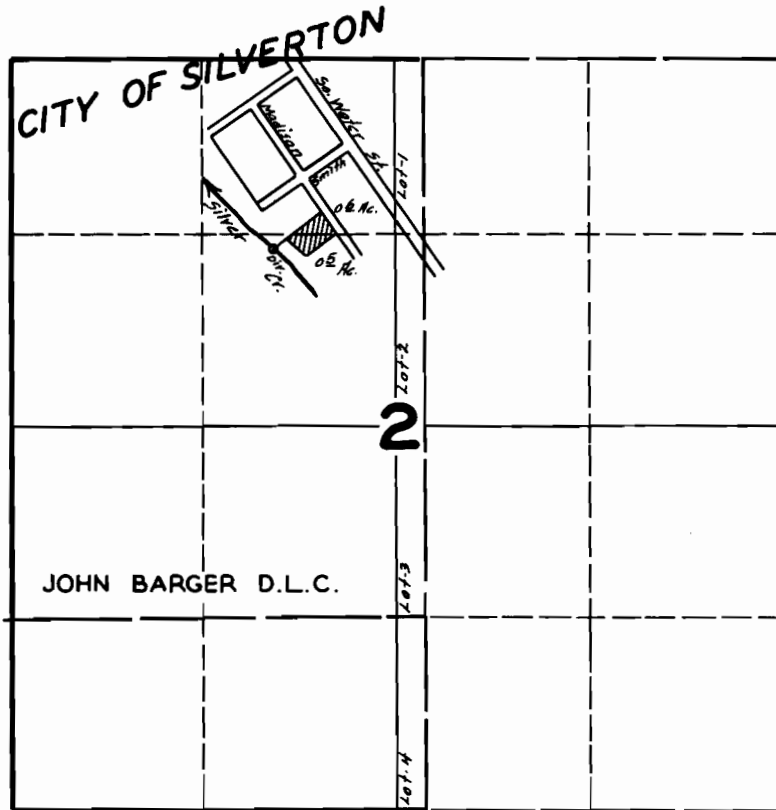

FINAL PROOF SURVEY UNDER

Application No. 21087... Permit No. 16525

IN NAME OF

KENNETH V. & ELIZABETH MINKLEY

Surveyed SEPT. 29 1945, by *Paul E. Russell*