


27

TOWNSHIP 40S, RANGE 4E, W. M.

North

Jenny Calkins

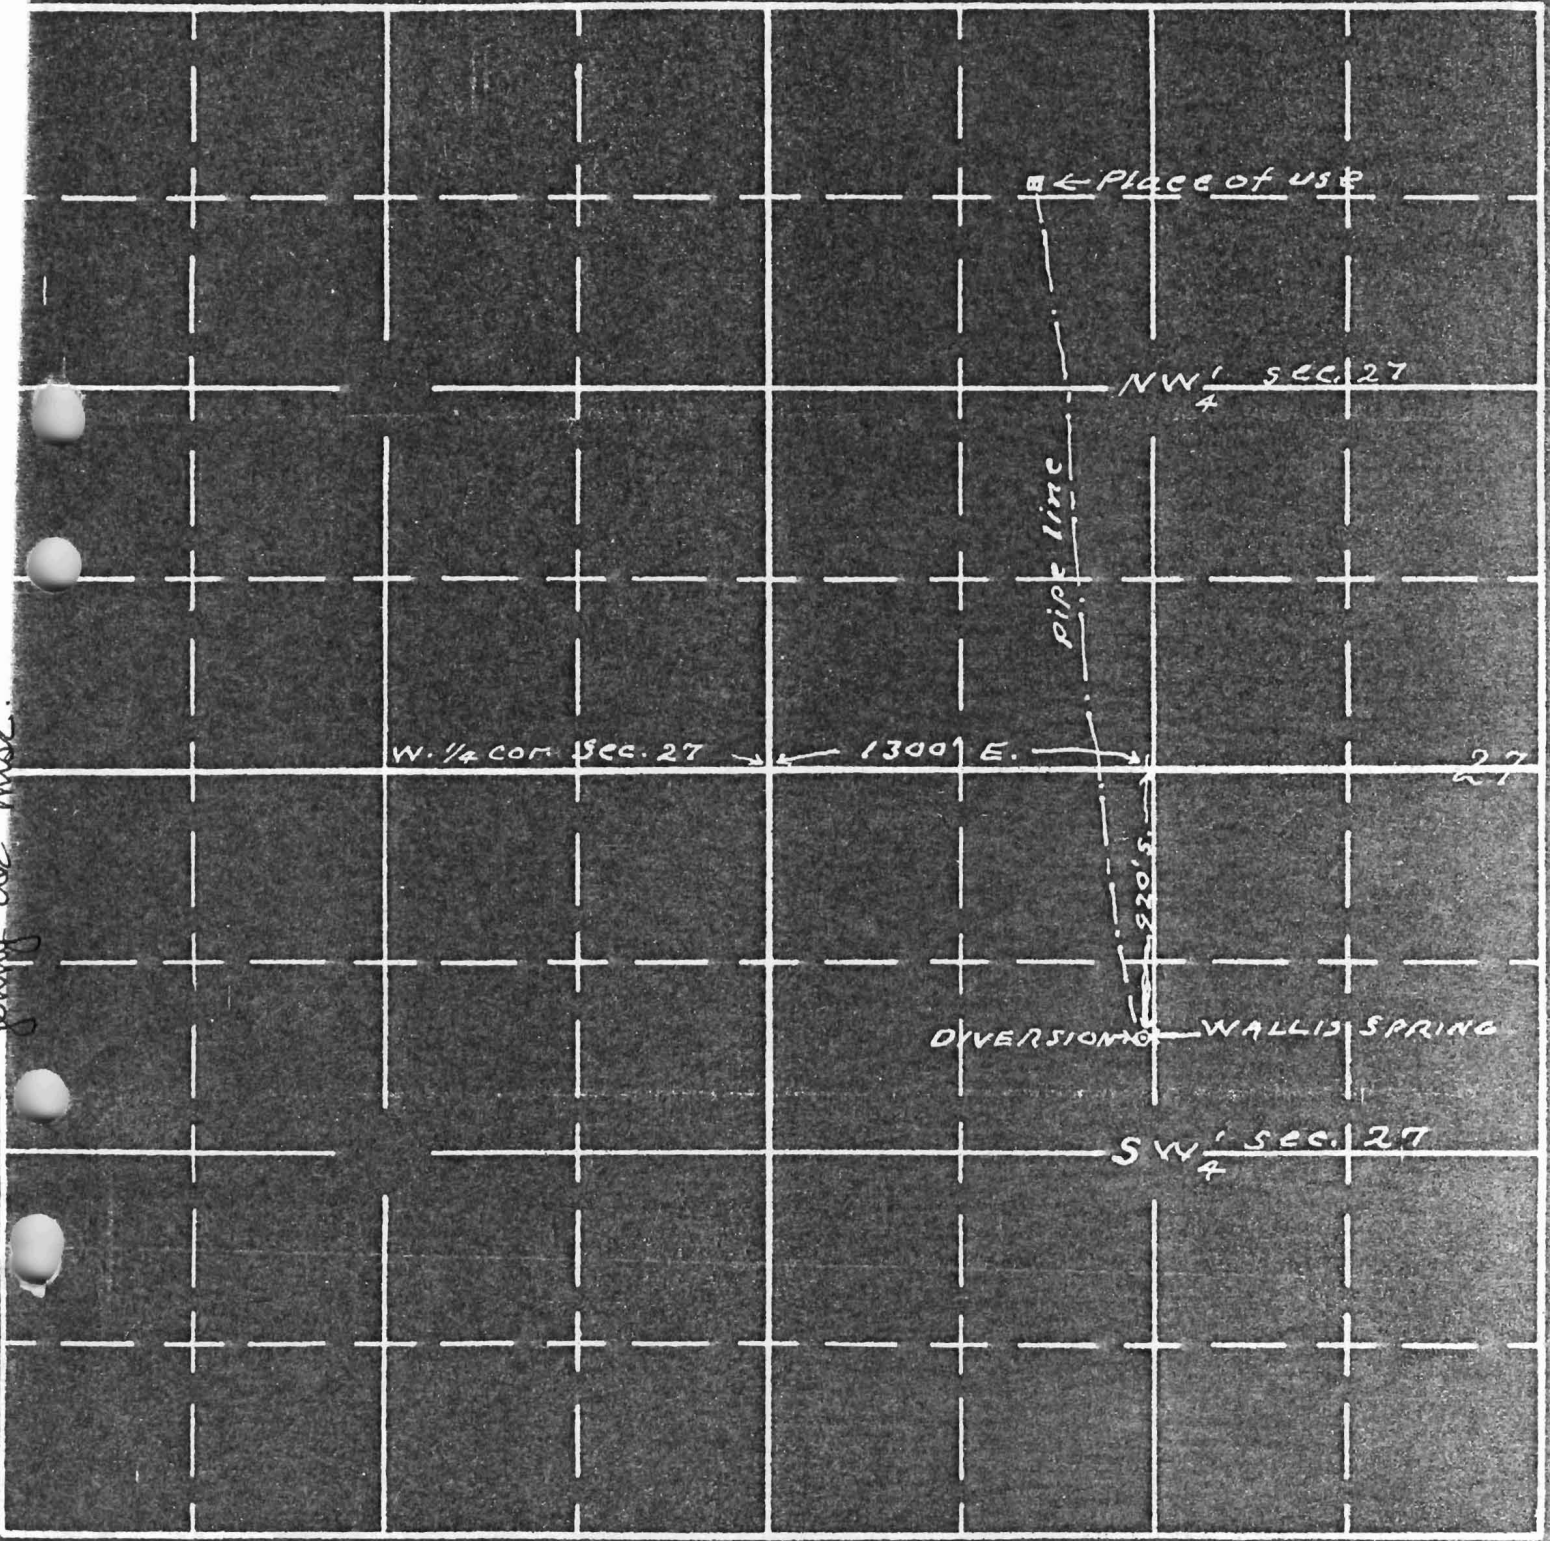

27

East

South

21178 14-11

Map to accompany application of W. H. Wallis for use of Wallis spring for domestic and garden purposes. Spring on his property.

Application No. 21178

Permit No. 16597

This office 9/18/45