


SECTION

32

TOWNSHIP 37S, RANGE 1E, W. M.

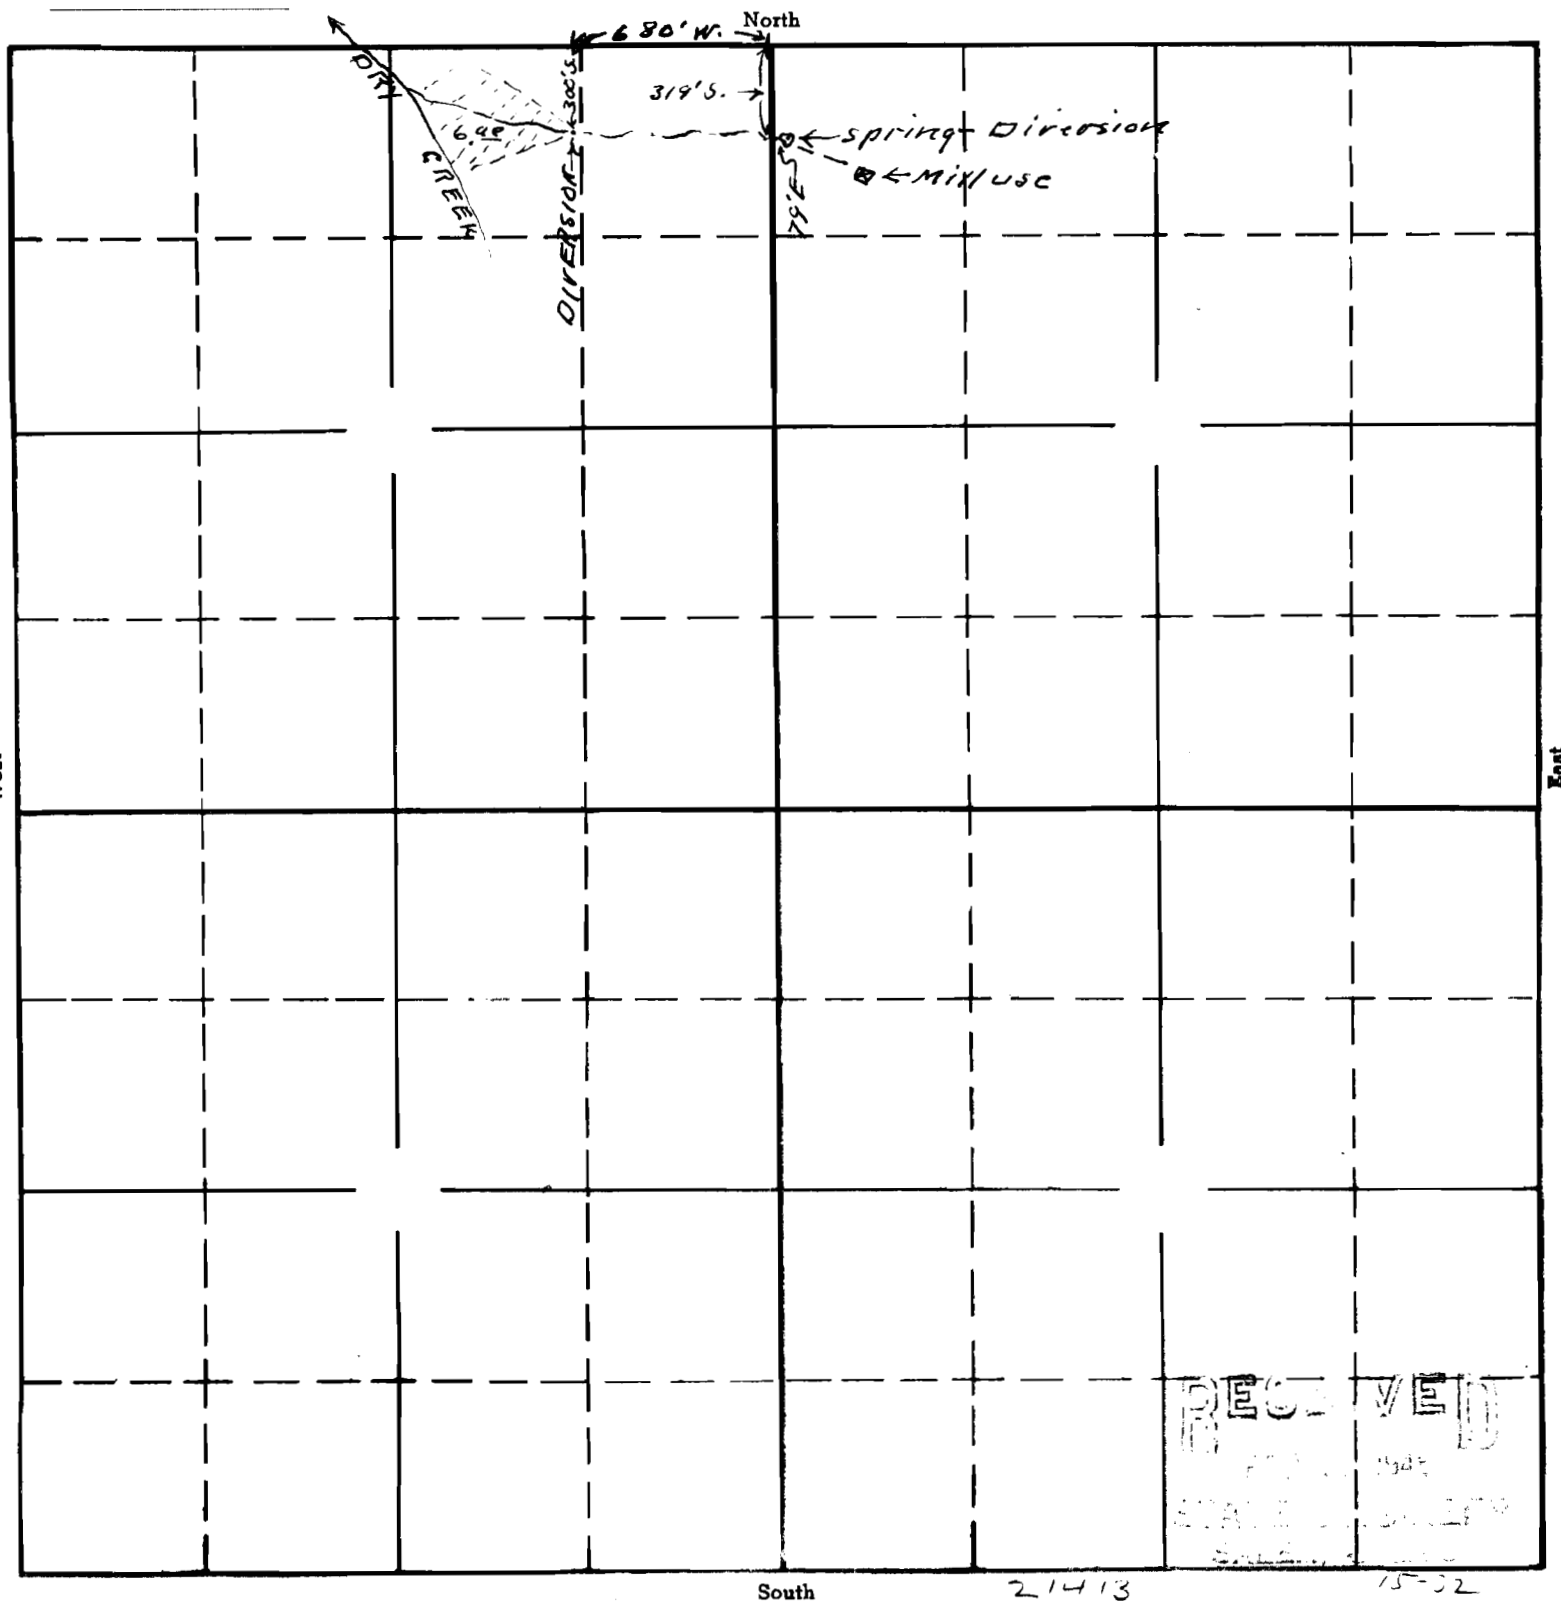

Map for application in the name of
Berton R Lapree for use of the
waters from unnamed spring and
draw for domestic, irrigation
and mfg. purposes.

This office 7/10/46 ~~thm~~

APPLICATION No. 21413
PERMIT No. 16779