


T.28S.R.14W.W.M.

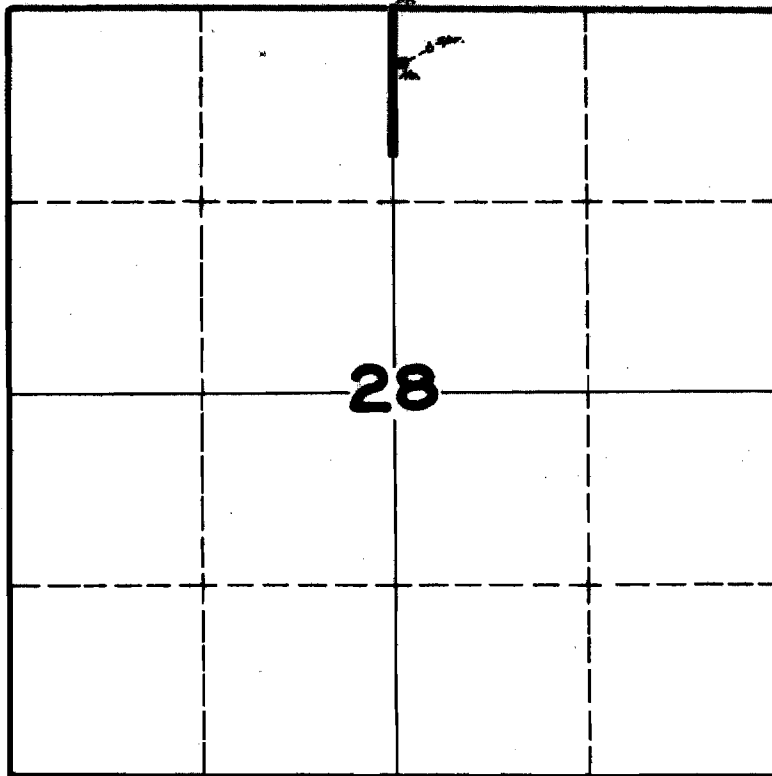

**FINAL PROOF SURVEY
UNDER**


Application No. 21494 Permit No. 16927

IN NAME OF

WAVA HAGA CHESLEY

Surveyed, PL. 24 1947, by JAS. E. BUNNELL

T.28S.R.14W.W.M.

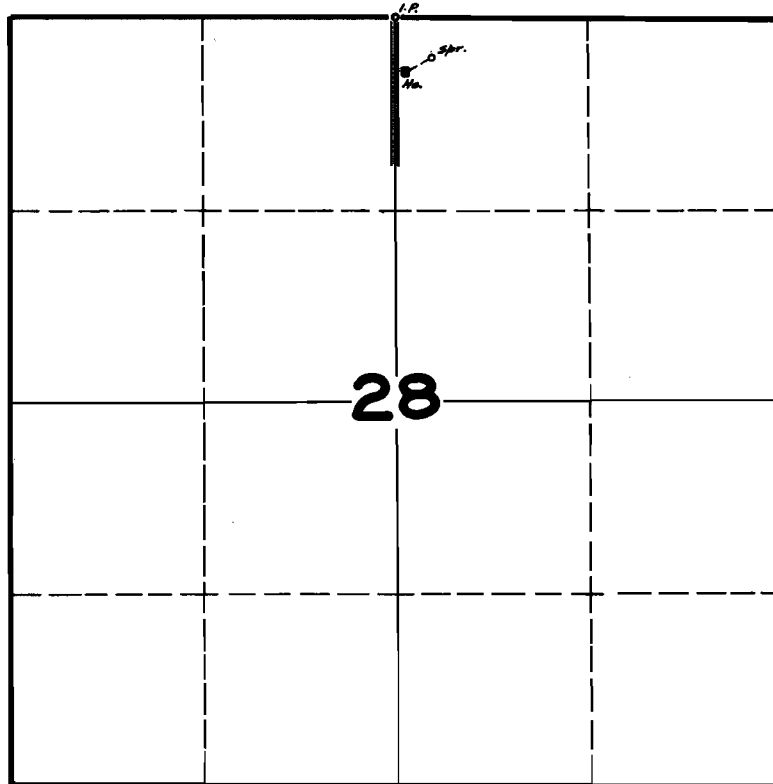

**FINAL PROOF SURVEY
UNDER**

Application No. 21494 Permit No. 16927

IN NAME OF

WAVA HAGA CHESLEY

Surveyed JUL. 24 1947, by JAS. E. BUNNELL