ECTION

13

TOWNSHIP 39S, RANGE 1E, W. M.

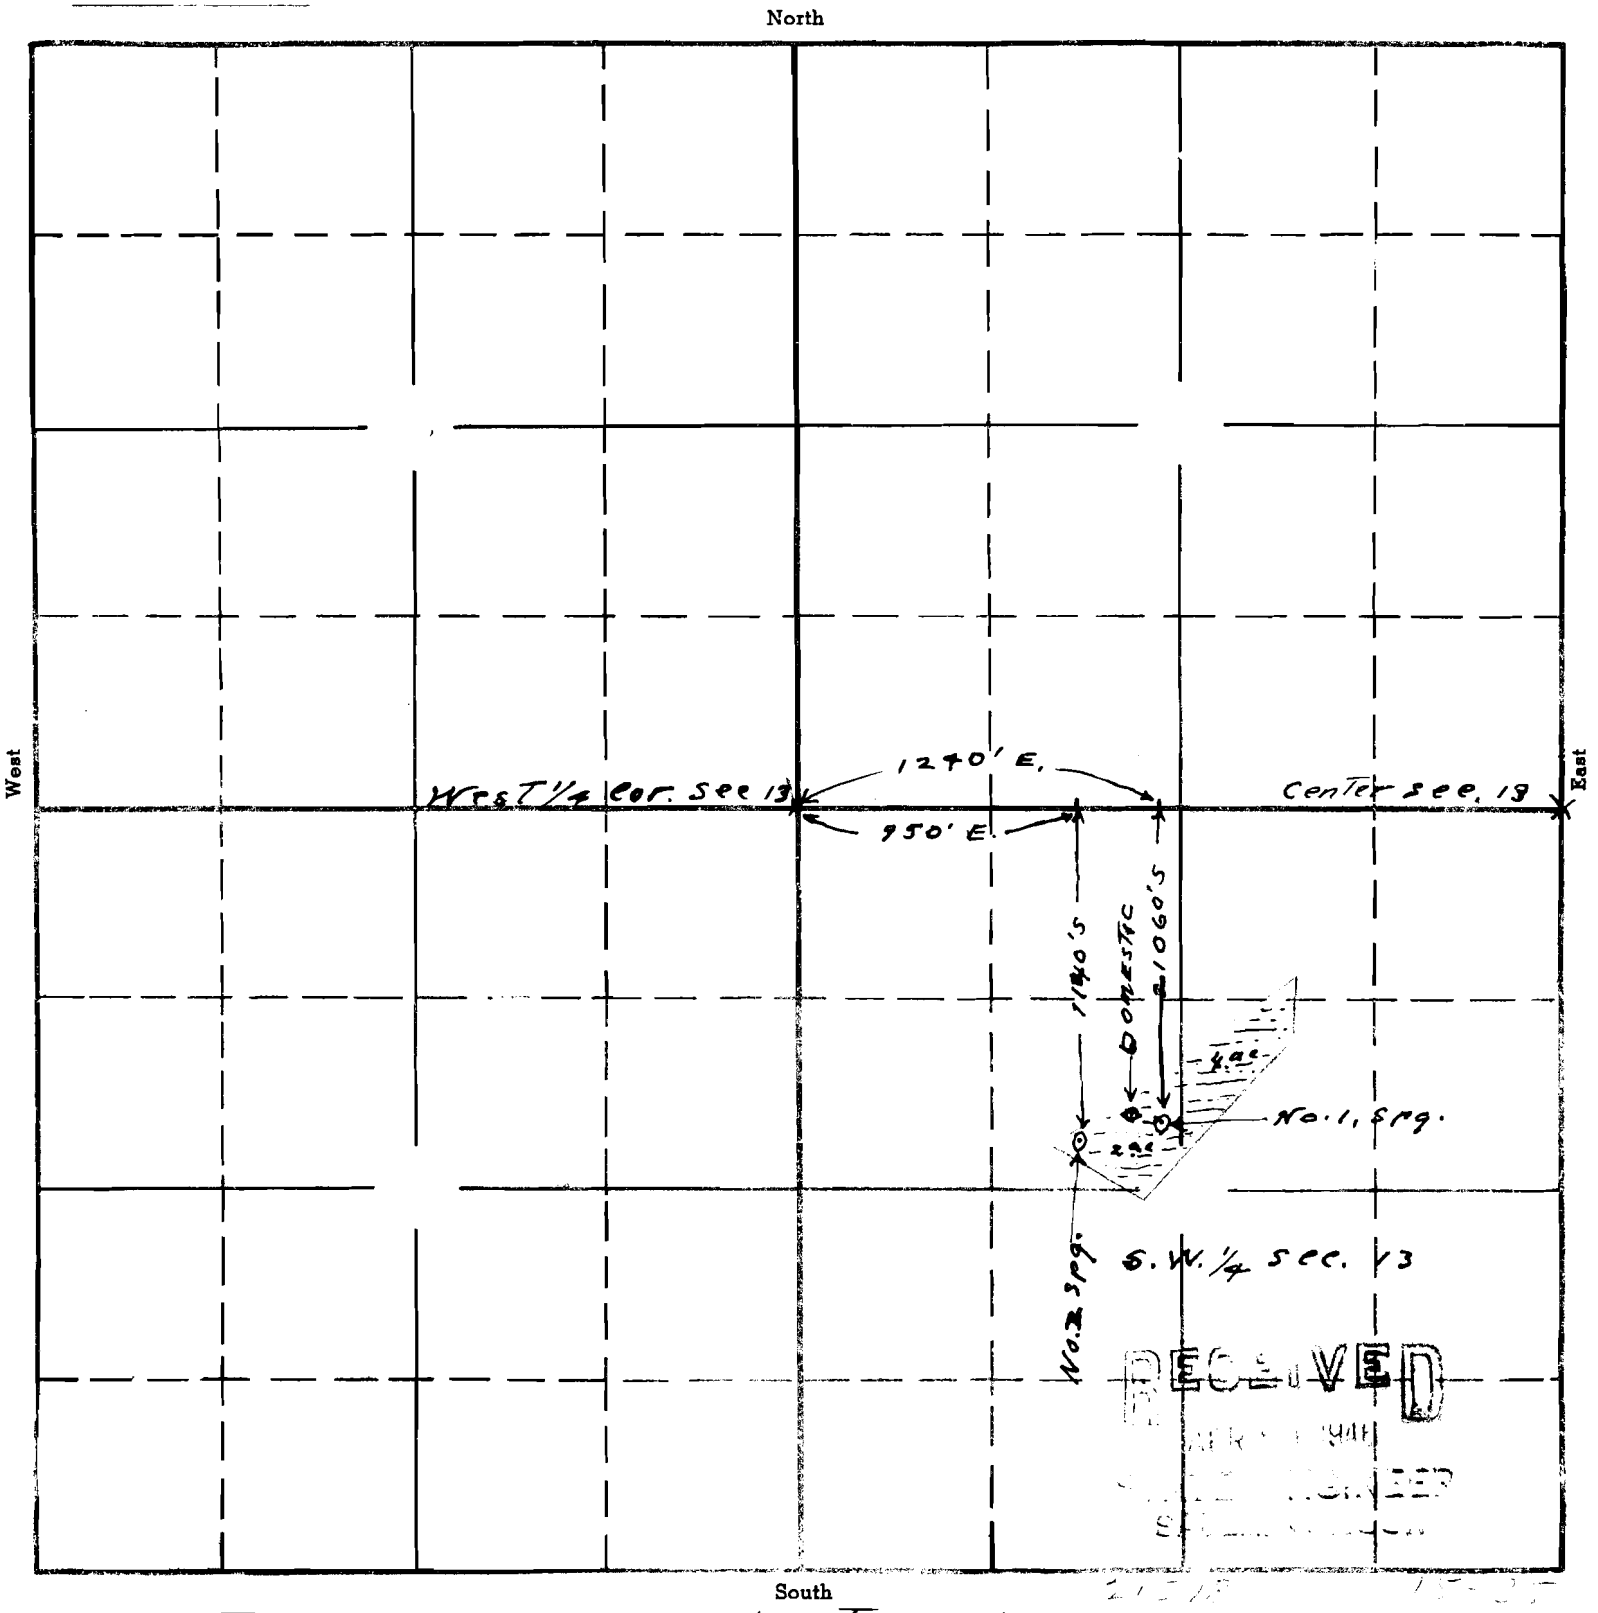

Map to accompany application of Robert O Boyd for permit to use waters from No. 1 & No. 2 springs for domestic and irrigation. Springs located on his lands.

This office 4/21/46

APPLICATION No. 21578
PERMIT No. 16956