


T.6S.R.8W.W.M.

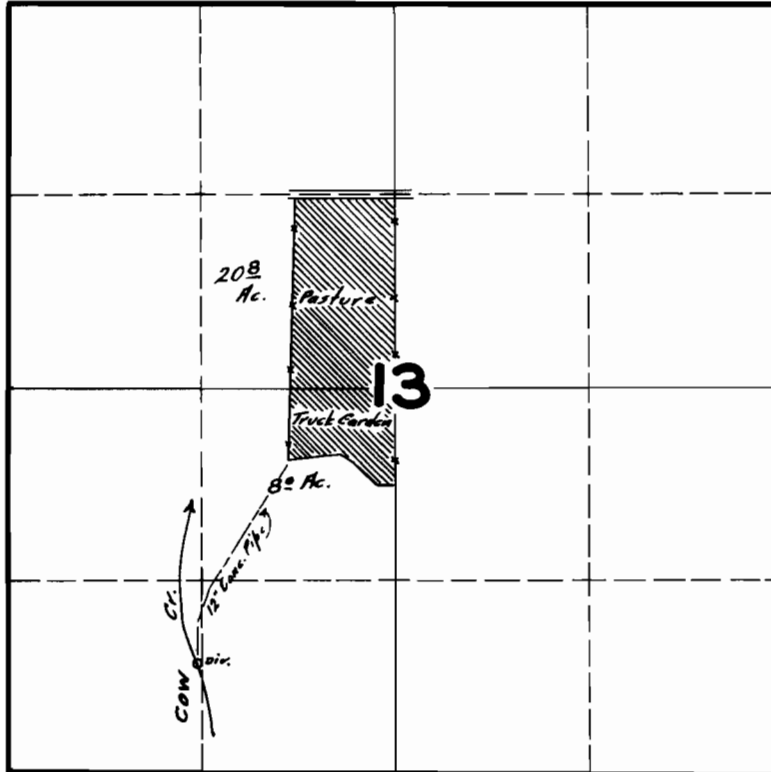

FINAL PROOF SURVEY UNDER

Application No. 15498 Permit No. 11382

IN NAME OF

MARJORIE REID

Surveyed SEPT. 10 1946, by J. J. Sumrell