


T.4 & 5S.R.4W.W.M.

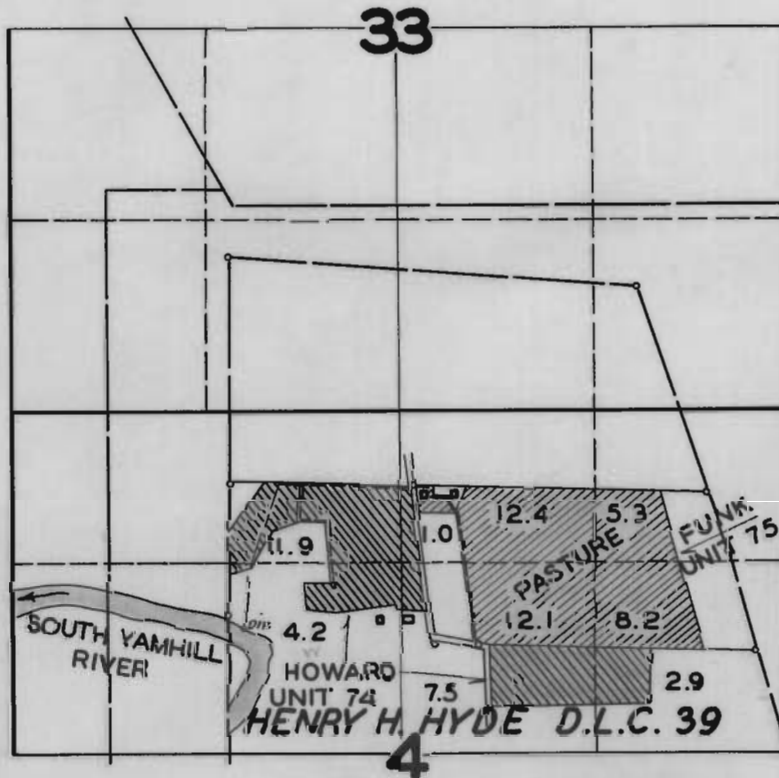

FINAL PROOF SURVEY

UNDER

Application No. 17767 Permit No. 13455

IN NAME OF

OREN H. & VERGIE A. HOWARD-AMEL & ZELDA M. FUNK

Surveyed MAR. 21, 1947, by JAS. E. BUNNELL