


T.19S.R.3W.W.M.

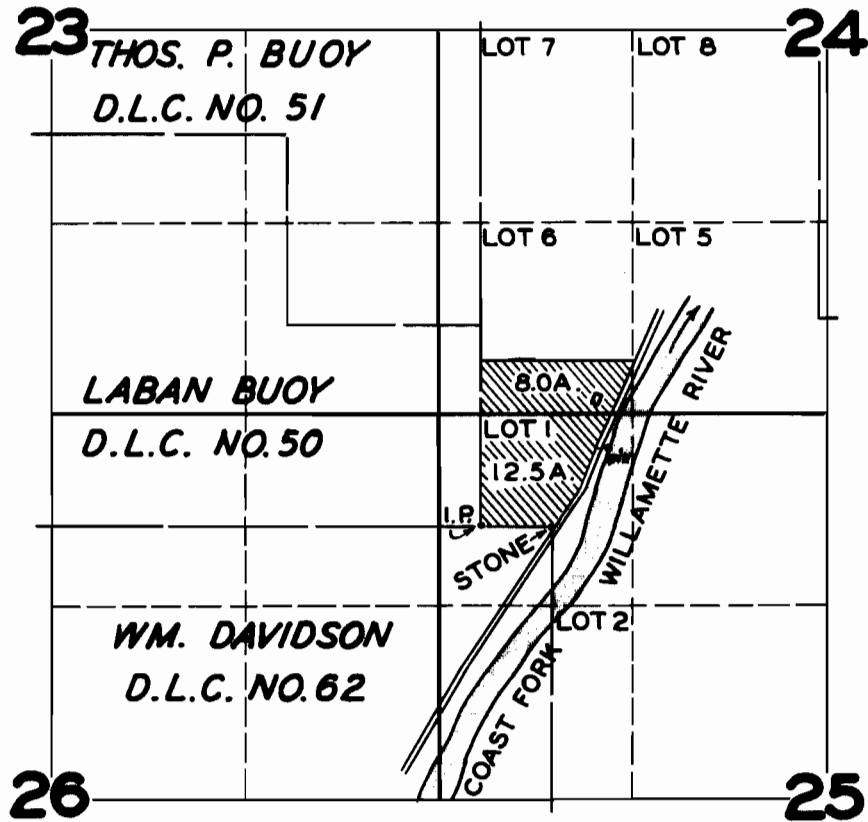

FINAL PROOF SURVEY

UNDER

Application No. 22113 Permit No. 17377

IN NAME OF

LOUIS GUTH & LOTTA GUTH

Surveyed JUL. 19. 1948, by JAS. E. BUNNELL