


Township 2 S.

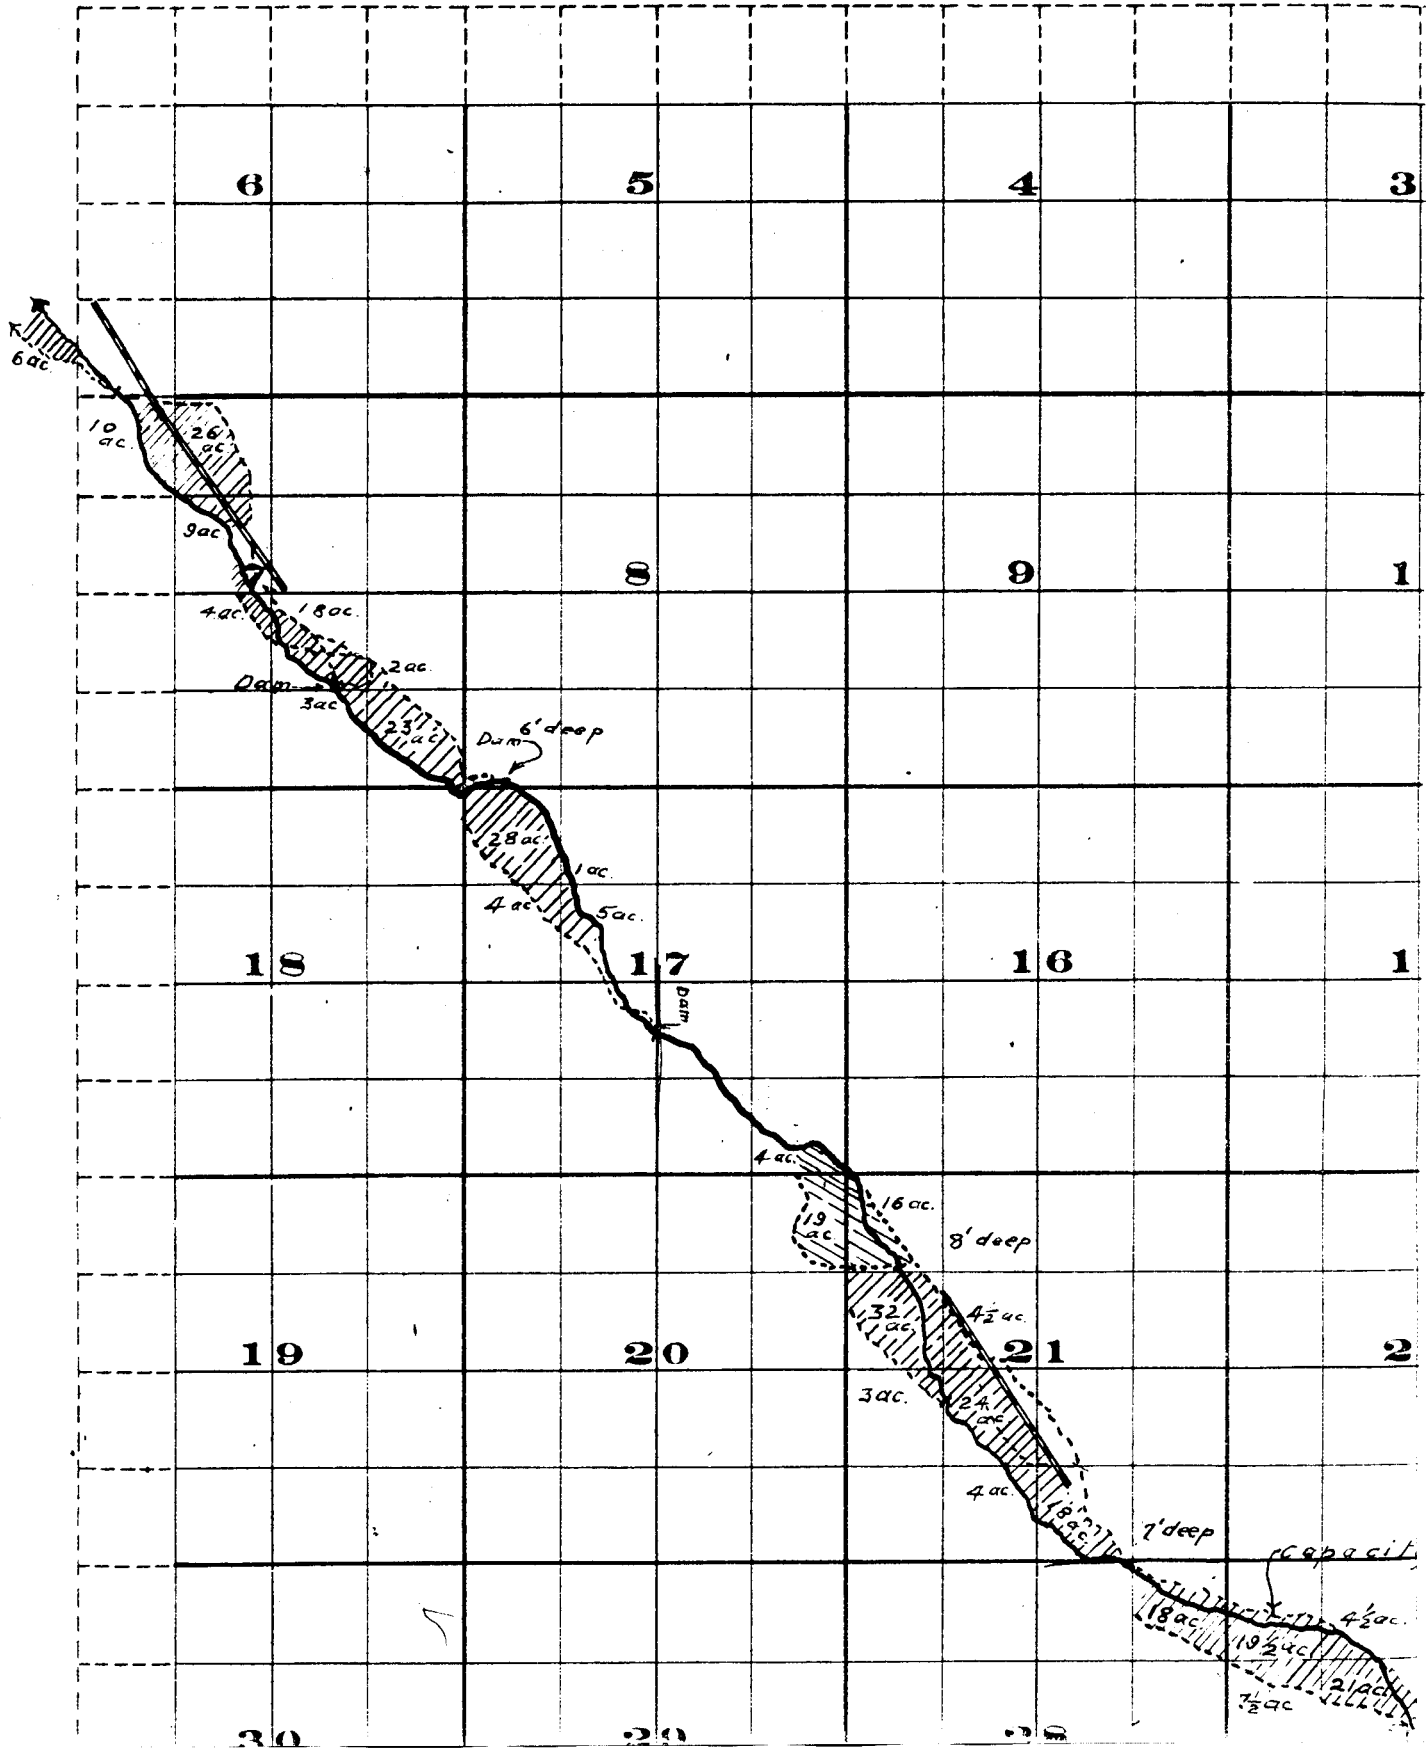

S. , Range 26 E. W. M.

