


T. 1N. R. 4W. W.M.

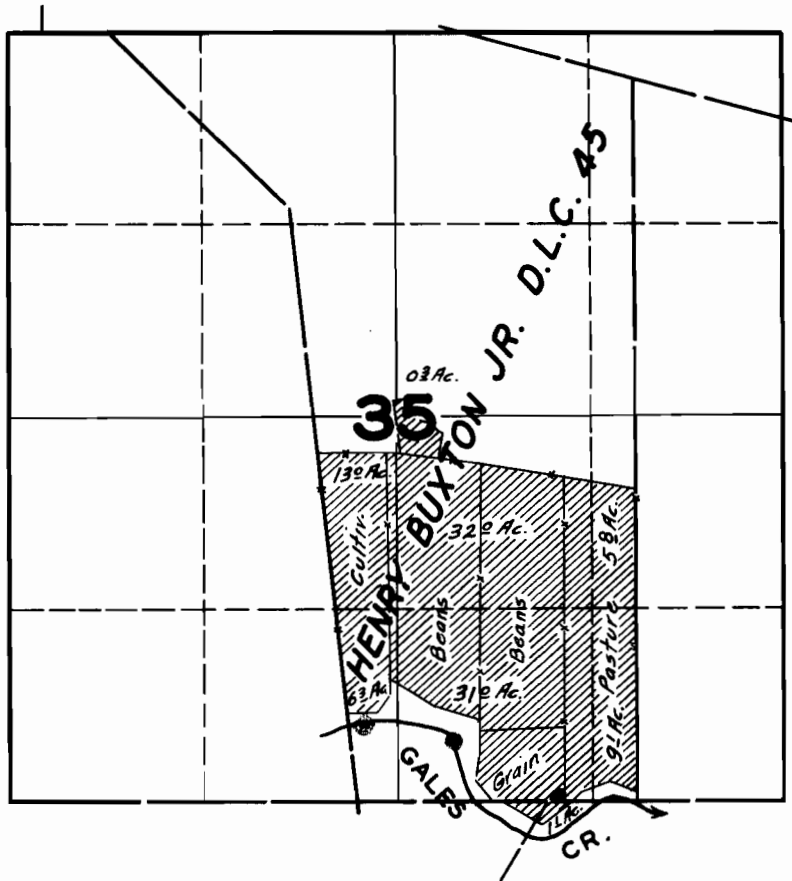

FINAL PROOF SURVEY
UNDER

Application No. **17888** Permit No. **13583**
IN NAME OF

E. A. RUETER

Surveyed **JULY 2**, 1947, by **JAS. E. BUNNELL**