


T.2S.R.2W.W.M.

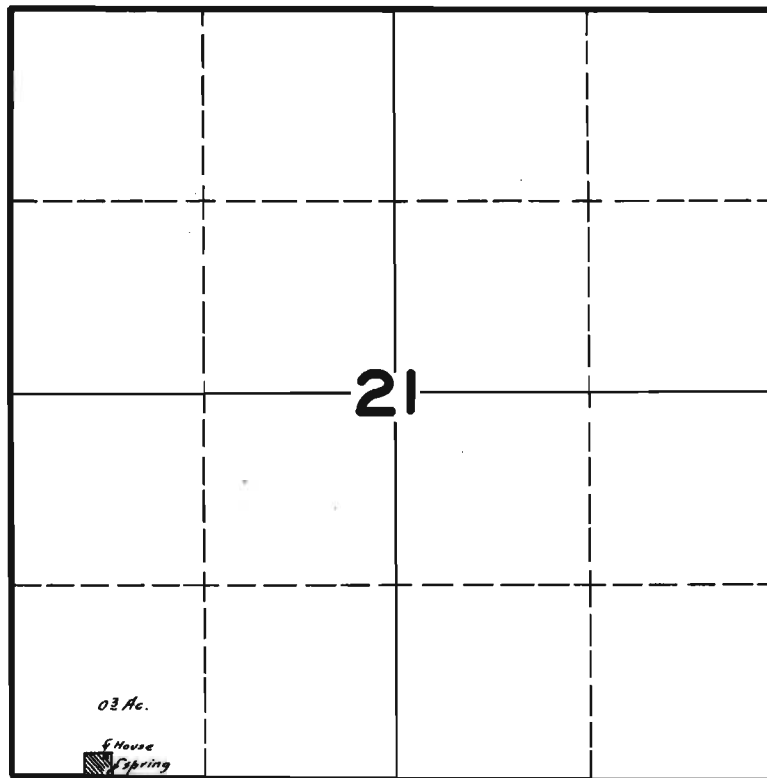

**FINAL PROOF SURVEY
UNDER**

Application No. 18376 Permit No. 14238

IN NAME OF

GLENN M. FIXSEN

Surveyed SEP. 12 1946, by