


TWP. 31 & 32 S. RGE. 41 & 42 E.

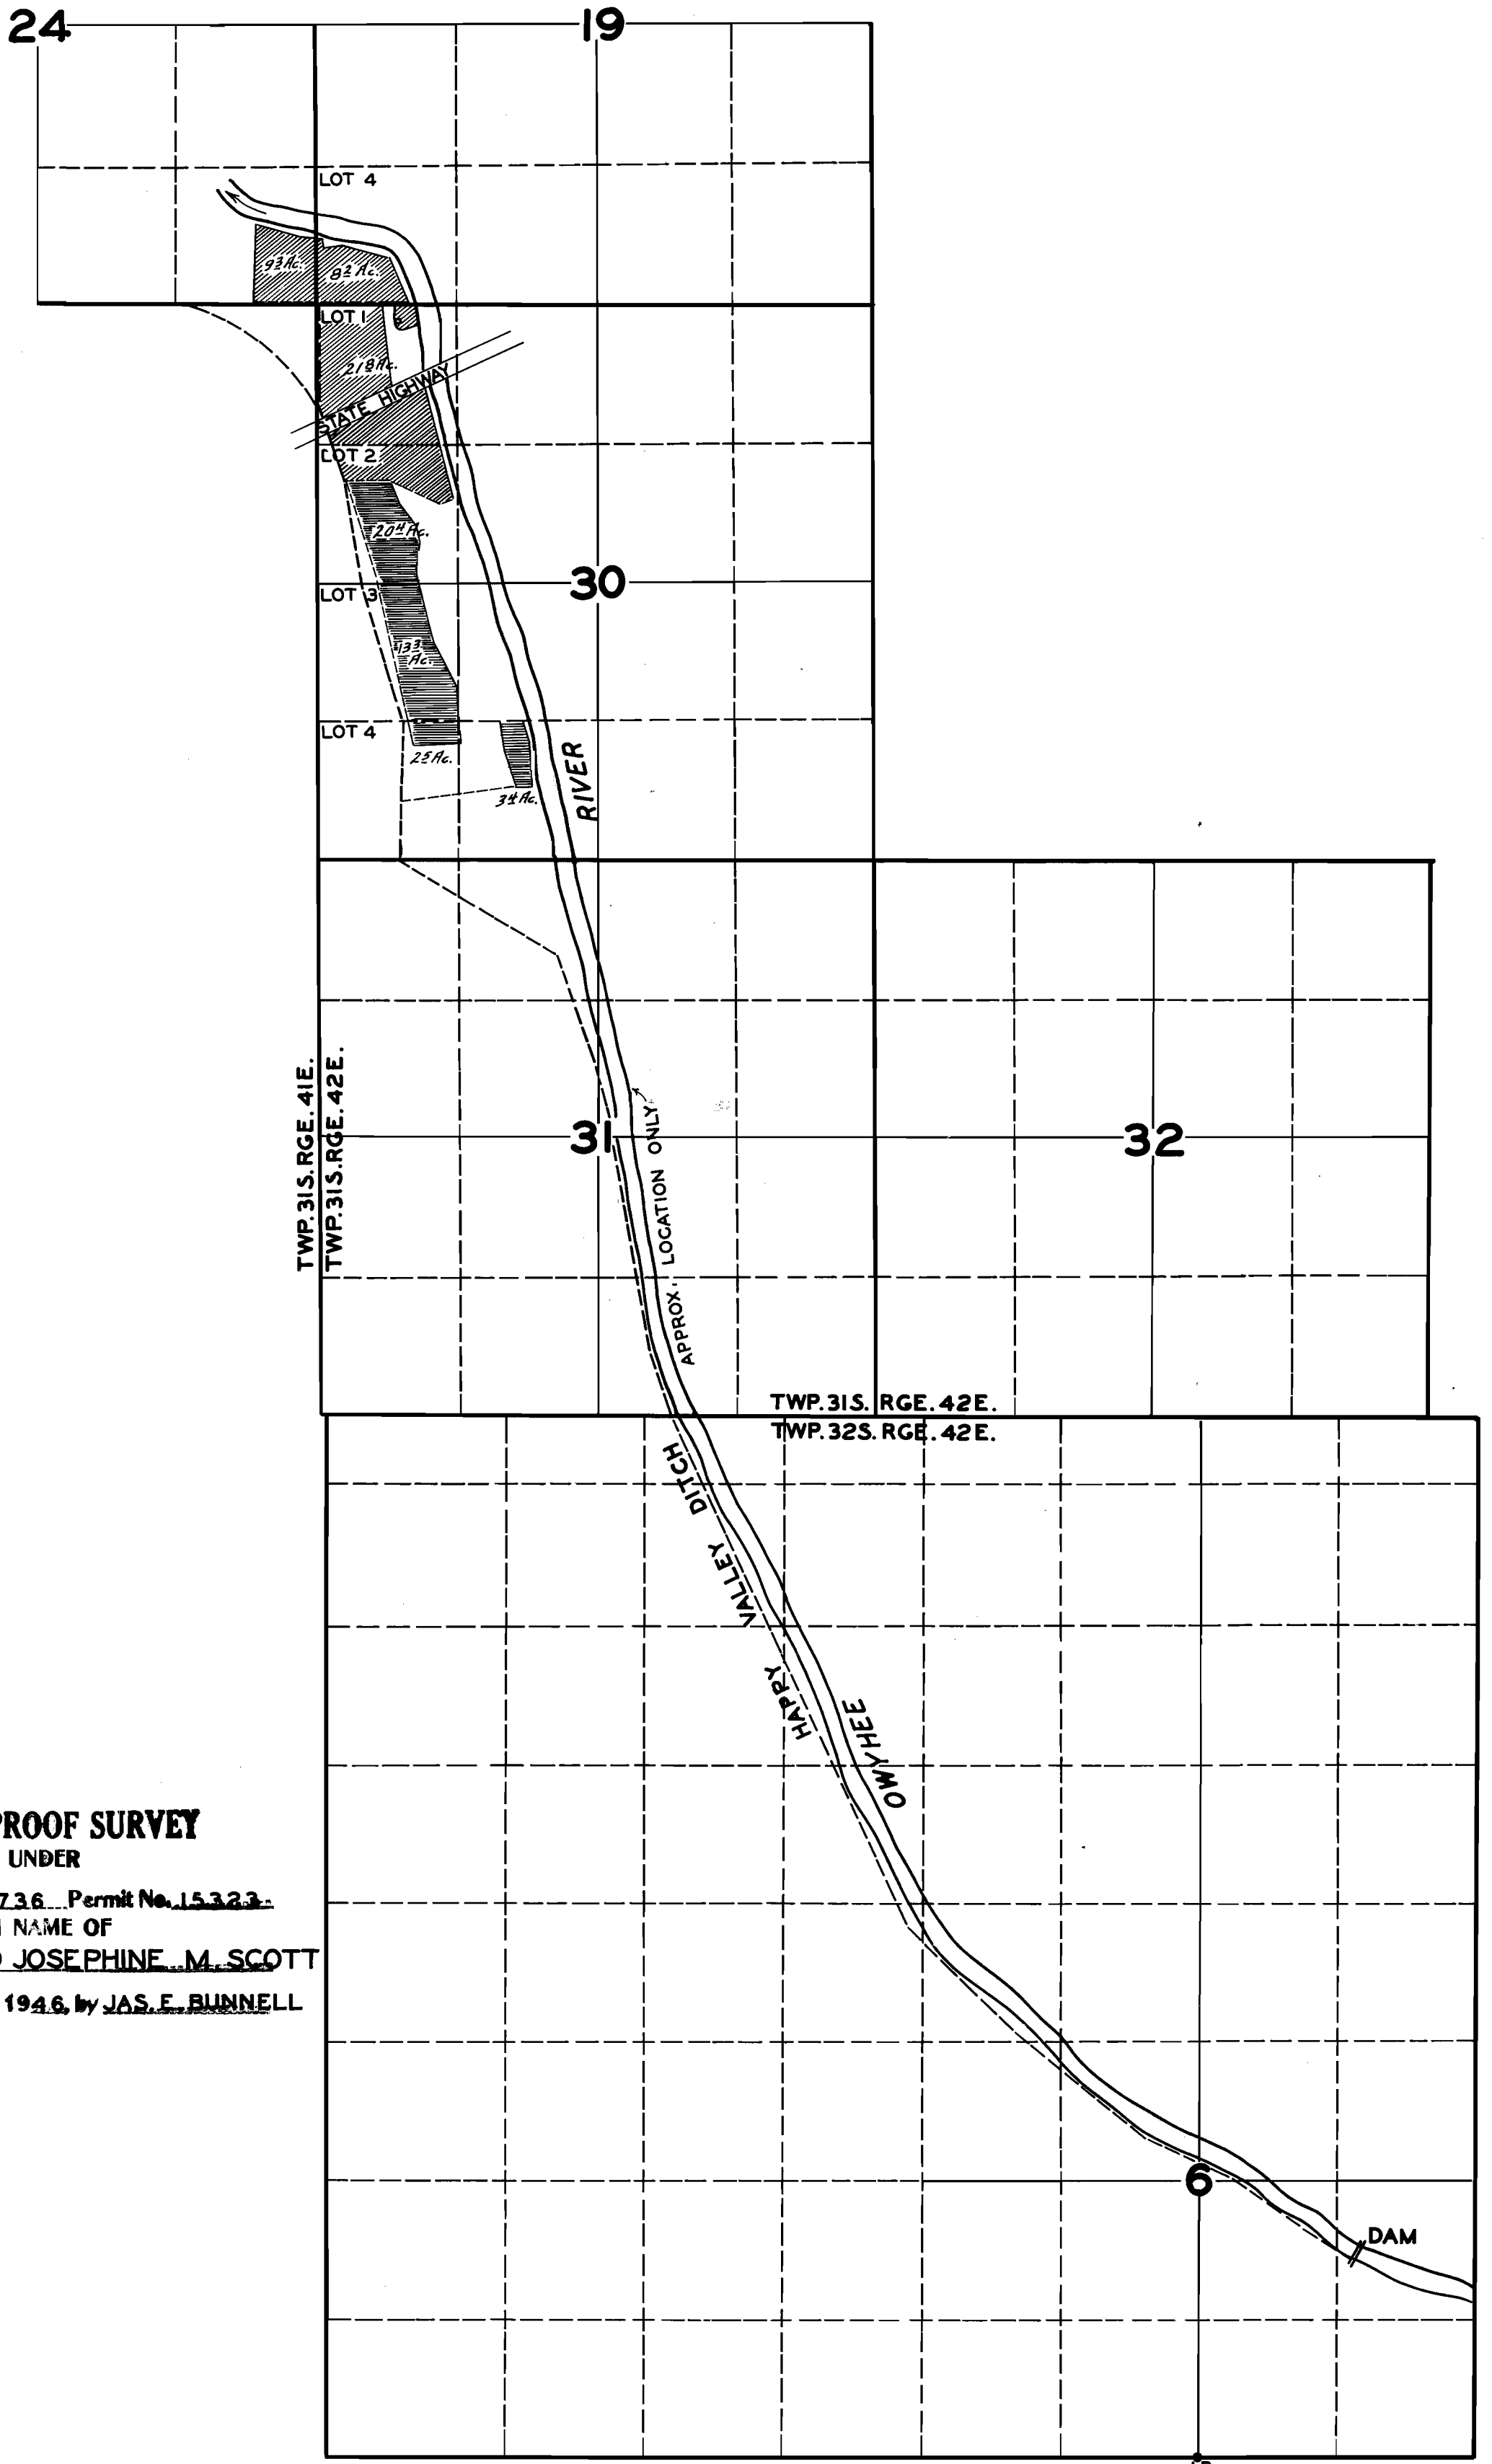

**FINAL PROOF SURVEY**  
UNDER  
Application No. 19736 Permit No. 15323  
IN NAME OF  
**FRED SCOTT AND JOSEPHINE M. SCOTT**  
Surveyed MAY 30 1946, by JAS. E. BUNNELL