


T.6N.R.35E.W.M.

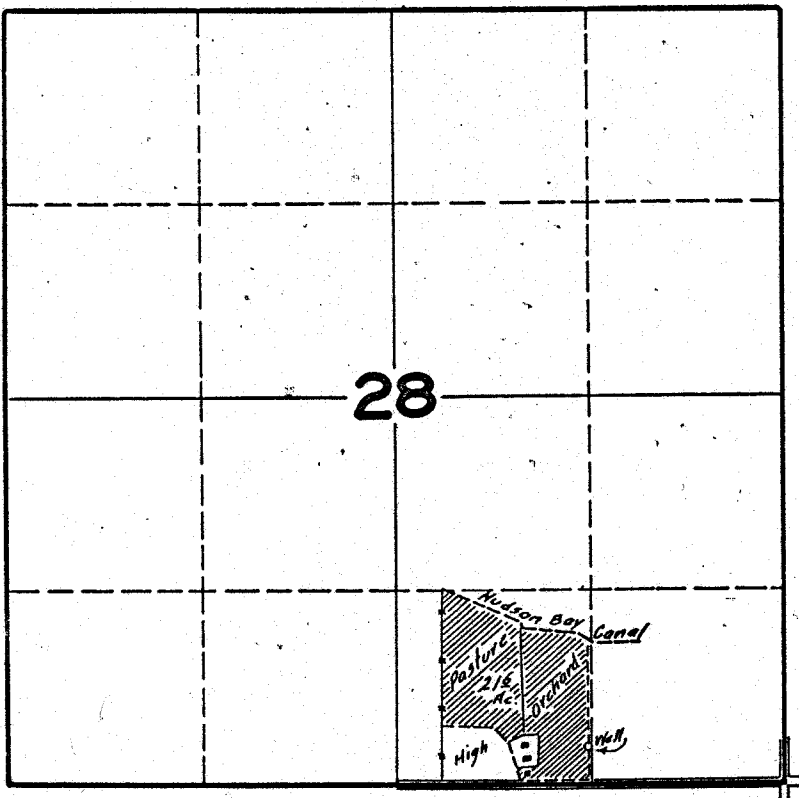

FINAL PROOF SURVEY UNDER

Application No. U-155 Permit No. U-148

IN NAME OF

C.O. WHEELER & WIFE VERGIE A. WHEELER

Surveyed APR. 19 1946, by *[Signature]*